

FINISH SCHEDULE				
KEY	MATERIALS			REMARKS
	FLOOR	BASE	WALLS	CEILING
1	BEDROOM	CP-1	POB	8'-6" 1, 3, 5, 6
2	BATHROOM	EXST	EXST	7-6 4
3	CLOSET	CP	POB	8-6 1, 3, 6
4	REMOVED BATHROOM	UN-C12	GC1	7-6 2, 5, 9
COMMON AREAS				
5	FOYER	ALUM. MAT	R8	EXST 8'-0" 8, 10
6	LOBBY	UN-C11	CT-2	POB EXST 8'-0" 1, 10
7	STAIR	UN-C11	CT-2	POB EXST 7-6 1, 7
8	CORRIDOR	CP-1	CP	POB EXST 7-6 1, 10
9	STARWELL FOYER	UN-C1	CT-2	POB EXST 8'-0" 1, 10
10	MULTIPURPOSE AREA	CP-1	CP	POB EXST 7-6 1, 10
11	JANITOR/SUPPLY CLOSET	UN-C11	CT-2	POB EXST 8-6 1, 10
12	MECHANICAL ROOM	EXST	NONE	WAKES
13	LAUNDRY ROOM	UN-C11	CT-2	POB EXST 8-6 1, 3
14	KITCHEN	UN-C11	CT-2	POB EXST 8'-0" 10
15	STORAGE	EXST	CP	POB EXST 8'-0" 10
16	DORM MANAGER	CP-1	CP	POB EXST 8-6 1, 3, 5, 6
17	CO	UN-C11	CT-2	POB EXST 8'-0" 10
18	PUBLIC TOILET	UN-C11	CT-2	POB EXST 8'-0" 10
19	ENTRY	UN-C11	CT-2	POB EXST 7-6 1, 8

- FINISH SCHEDULE REMARKS:
1. TO RECEIVE CORNER BOARD WALLS AND CEILINGS
 2. TO RECEIVE KNOCK DOWN FINISH AND PAINT
 3. EXPOSED BOTTOM OF SECOND FLOOR SLAB
 4. NO WORK THIS ROOM
 5. SEE DWG A-7 FOR TRANSITION STRIP DETAIL
 6. DORM CEILING HEIGHT AT 8'-6", SOFFITS AT 7'-6"
 7. CERAMIC TILE AT LANDING
 8. INSTALL HOLD DOWN CLIPS AT CEILING AT ENTRY VESTIBULES.
 9. REMOVED BATH REFER TO ENLARGED PLAN
 10. REPLACE DAMAGED CEILING TILES AS REQUIRED

- FINISH LEGEND:
- FLOOR:

CP-1

UN-C11

UN-C12

CARPET (LOOP PILE)

UN-C11

UN-C12

UNGLAZED CERAMIC TILE
- BASE:

CP

CT-1

CT-2
- 4" CARPET BASE WITH STAINED EDGE

CARPET TO MATCH ADJACENT FLOOR

COVE CERAMIC TILE TO MATCH WALL

BULL NOSE 4" X 6" UNGLAZED CERAMIC TILE TO MATCH FLOOR
- WALLS:

GC1

GC2

POB
- GLAZED CERAMIC TILE

PAINTED GYPSUM BOARD
- CEILING:

24" X 24" ACoustICAL, LAY-IN TILE

24" X 24" VINYL FACED ACoustICAL

LAUNDRY CONCRETE STRUCTURE - PAINTED

ST-PT

PAINTED GYPSUM BOARD

WALL AND CEILING KEY NOTES:

- 1 PROVIDE KNOCK DOWN FINISH, PRIMER COAT AND PAINT COATS TO ALL SURFACES
- 2 PAINTED GYPSUM BOARD
- 3 REPAIR DAMAGED GYP. BD. AS REQ'D FOR NEW PAINT FINISH.
- 4 INSTALL NEW CEILING TILES AND GRID TO MATCH EXISTING
- 5 REFINISH EXISTING WOOD HANDRAIL AND REFINISH METAL HANDRAILS IN STAIRWELLS FOR LIKE NEW APPEARANCE.
- 6 ROOM NUMBER SIGNAGE AND DIRECTIONAL SIGNAGE TEXT TO BE DETER. BY OWNER. ACTUAL LOCATION RE: E-1
- 7 REPLACE ALL EXISTING CEILING FANS WITH SPECIFIED MODELS.



- ## OPENING KEY NOTES:
- 13 RESTORE ALL STEEL DOOR FRAMES TO A LIKE NEW APPEARANCE AND FUNCTION - SURFACE PREPARATION, WELDING, GRINDING OF ALL STEEL DOOR FRAMES AND INSTALL PRIMER AND PAINT COATS TO ALL
 - 14 REMOVE AND REPLACE DOOR FRAMES - LOCATIONS AS PER PLAN
 - 15 INSTALL DOOR CLOSER ON ALL DOORS
 - 16 ALL EXISTING WOOD DOORS SHALL BE REFINISHED AND REINSTALLED IF DOOR IS UNABLE TO BE REPAIRED. REPLACE TO MATCH EXISTING.
 - 17 IDENTIFY DOOR HARDWARE THAT DOES NOT MATCH AND REPLACE
 - 18 REPLACE AND REPAIR EXISTING 2" SOLID PLASTIC VERTICAL BLINDS. REMOVE EXISTING PLASTIC BLINDS AND REPAIR OR REPLACE WITH NEW. ALL VENTED BLINDS SHALL BE "LIKE NEW" APPEARANCE.

MILLWORK CABINETRY KEY NOTES:

- 19 STAIN GRADE WOOD BASE VANITY CABINET WITH 4" BACKSPLASH AND 2" BLUEGRASS SOLID SURFACE AT LAVATORY TO MATCH EXISTING.

MISC. GENERAL KEY NOTES:

- 20 NEW FIRE EXTINGUISHER CABINET. REUSE EXISTING FIRE EXTINGUISHER
- 21 PLASTIC CORNER GUARDS - TYPICAL AT ALL CORNERS IN CORRIDOR & CIRCULATION AREAS.
- 22 PROVIDE SOLID SURFACE (CORIAN OR EQUAL) WINDOW SILLS.
- 23 NEW UPPER CABINET TO MATCH EXISTING
- 24 2"-4" WIDE EXTRUDED ALUMINUM FLOOR TRANSITIONS BETWEEN FLOOR FINISH MATERIALS

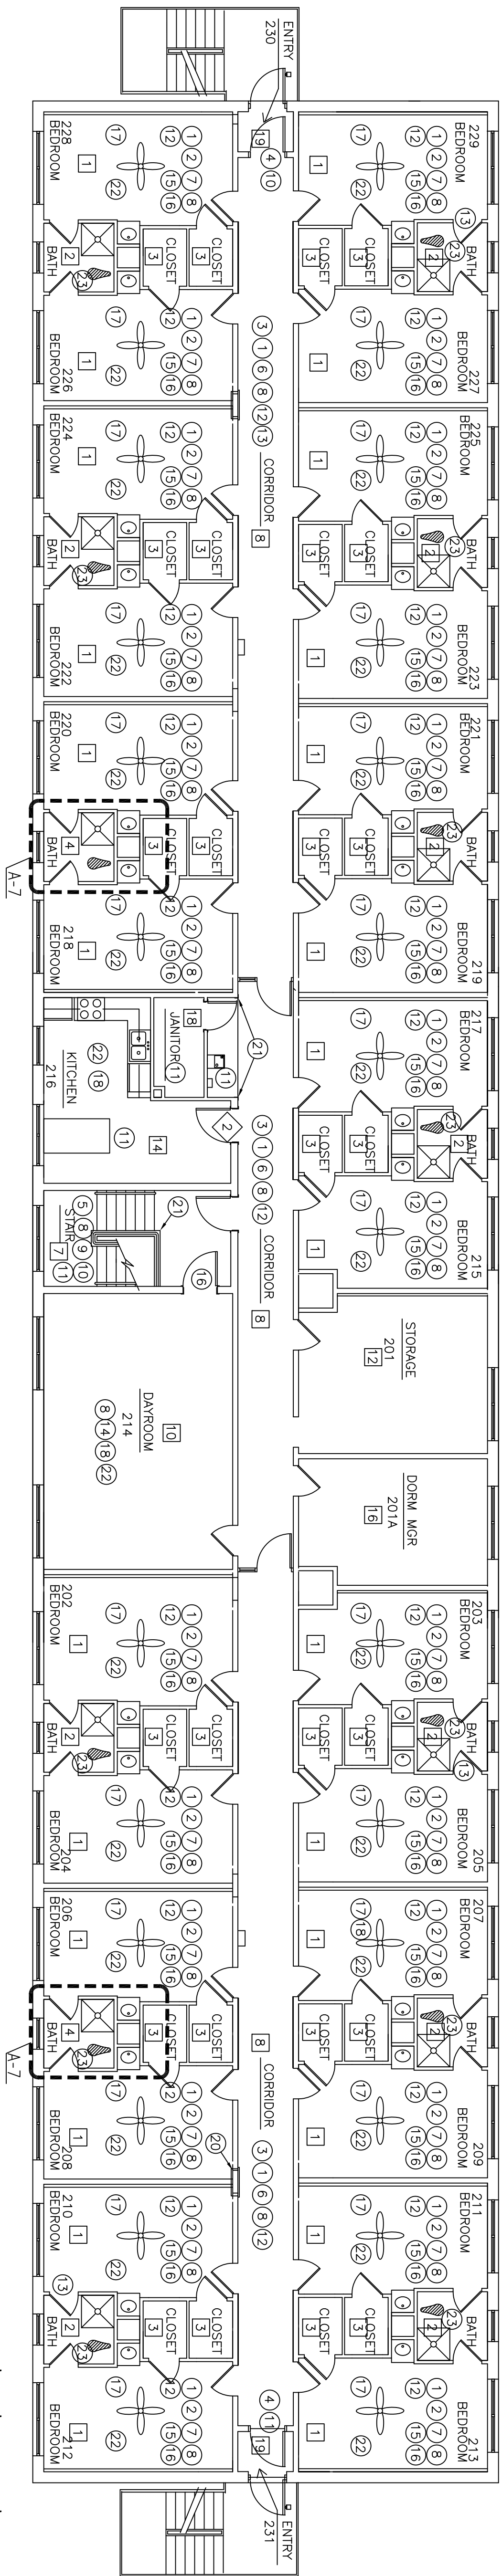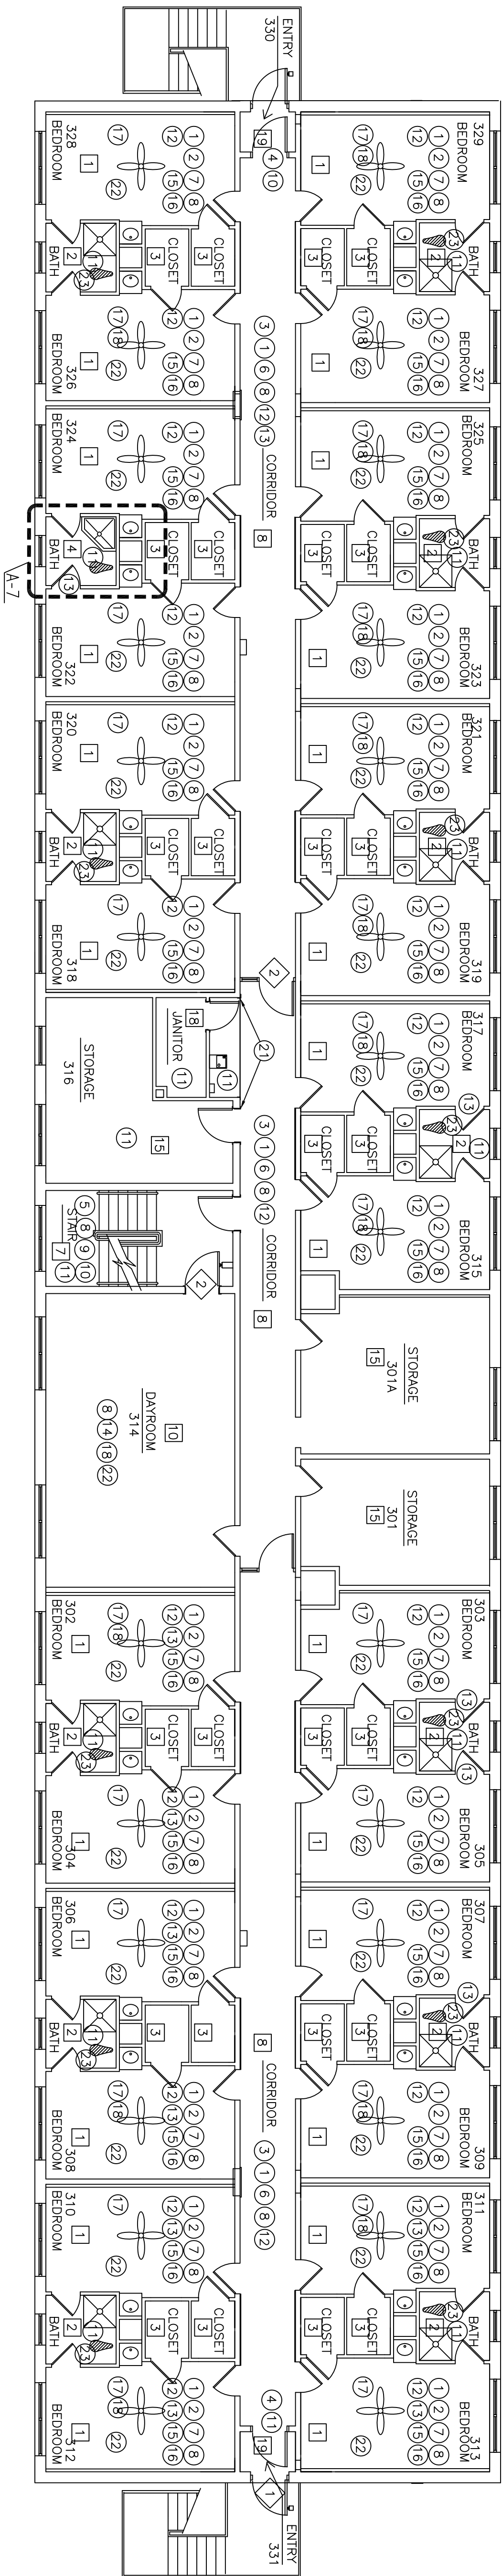

LITTLE ROCK A.F.B.
ARKANSAS



APP'D	BY	Date	Revision/Issue	No.

PROJECT TITLE
REPAIR DORM SHOWERS /
ROOM FINISHES
SUSTAIN ROOF REPAIR
DORM 768

SHEET TITLE
2ND & 3RD FLOOR
REFERENCE PLAN /
FINISH SCHEDULE

DRAWN BY KV TECH. REVIEWER BK DESIGNED BY COP DATE MARCH 27, 2009 SCALE AS SHOWN	LEAD DESIGNER CJF FILE LOCATION PROJECT NUMBER MMAK 07-1056 / 1056A SHEET A-5 6 of 12
---	--

AS-BUILT DRAWING