




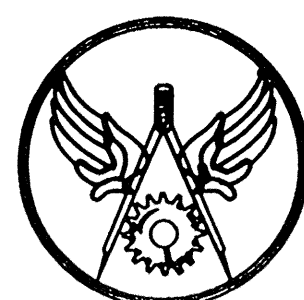

CTGB 09-2046

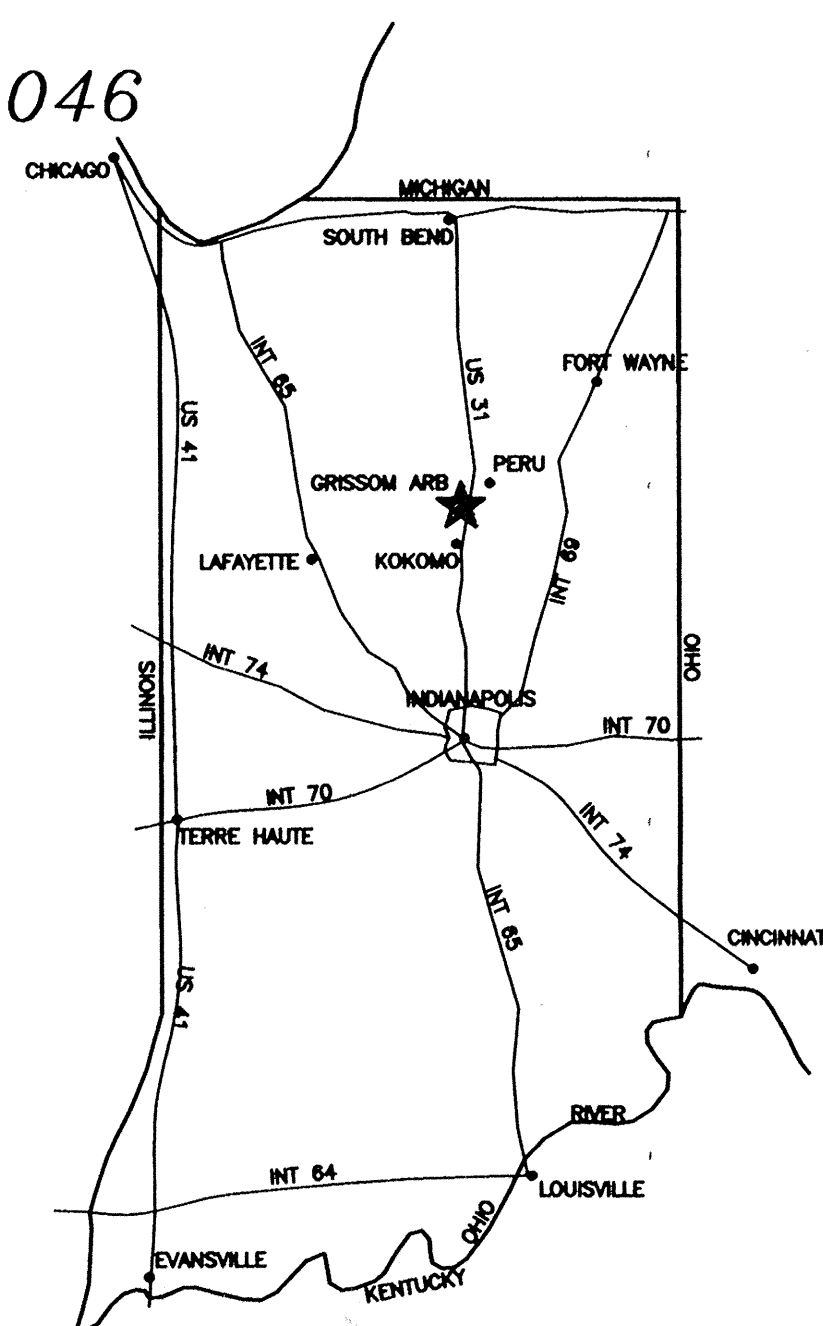

1 STATE OF INDIANA
G001

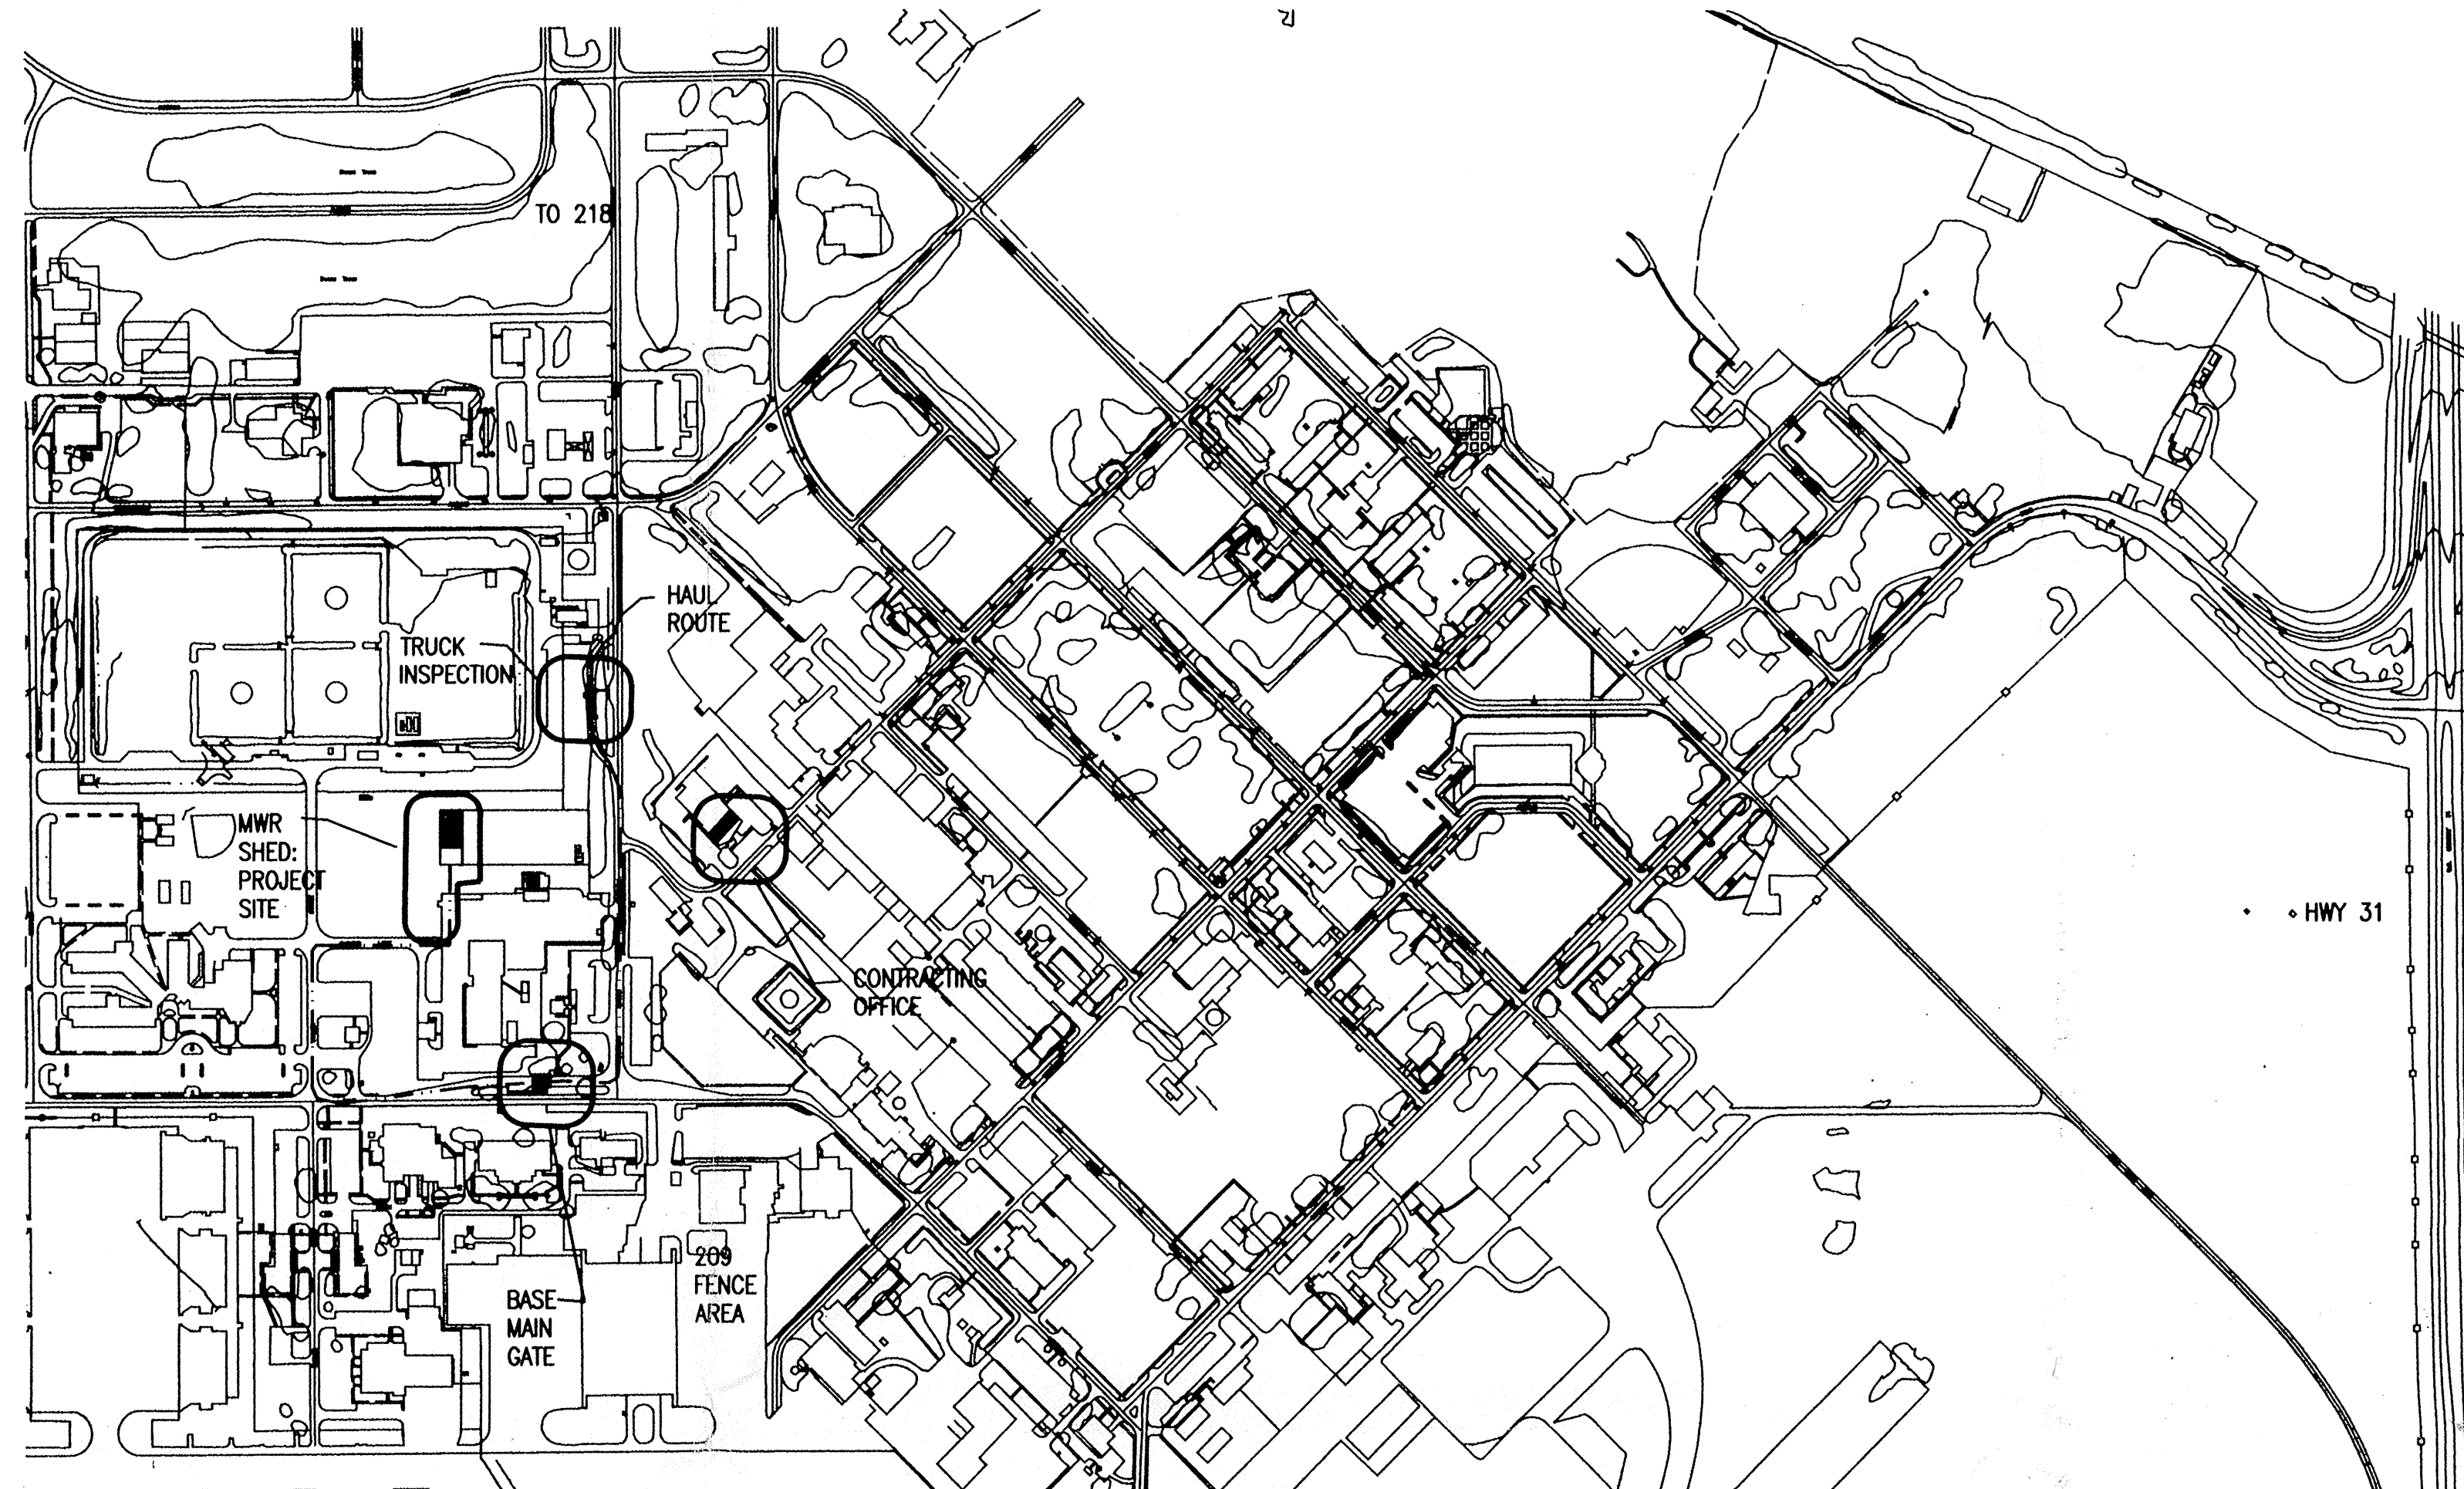

2
G001



434th BASE CIVIL ENGINEER
GROSSMAN AIR RESERVE BASE
INDIANA

[illegible]

Designed by:	Date:	Rev.
	JULY 2009	
Drawn by:	Project No.	CTSB 09-2046
Chd by:		
Reviewed by:	Scale:	$1" = 1'-0"$
Submitted by:	File name:	
	Plot date:	

Subject Title:

CONSTRUCT MWR STORAGE

Title: TITLE SHEET AND SITE PLAN

Sheet
reference
number:
G101
Sheet 1 of


SYMBOLS

SHEET WHERE
DRAWING IS
REFERENCED

1
2

PLAN VIEW

1
TITLE SYMBOL
DETAIL NUMBER
DETAIL LOCATION

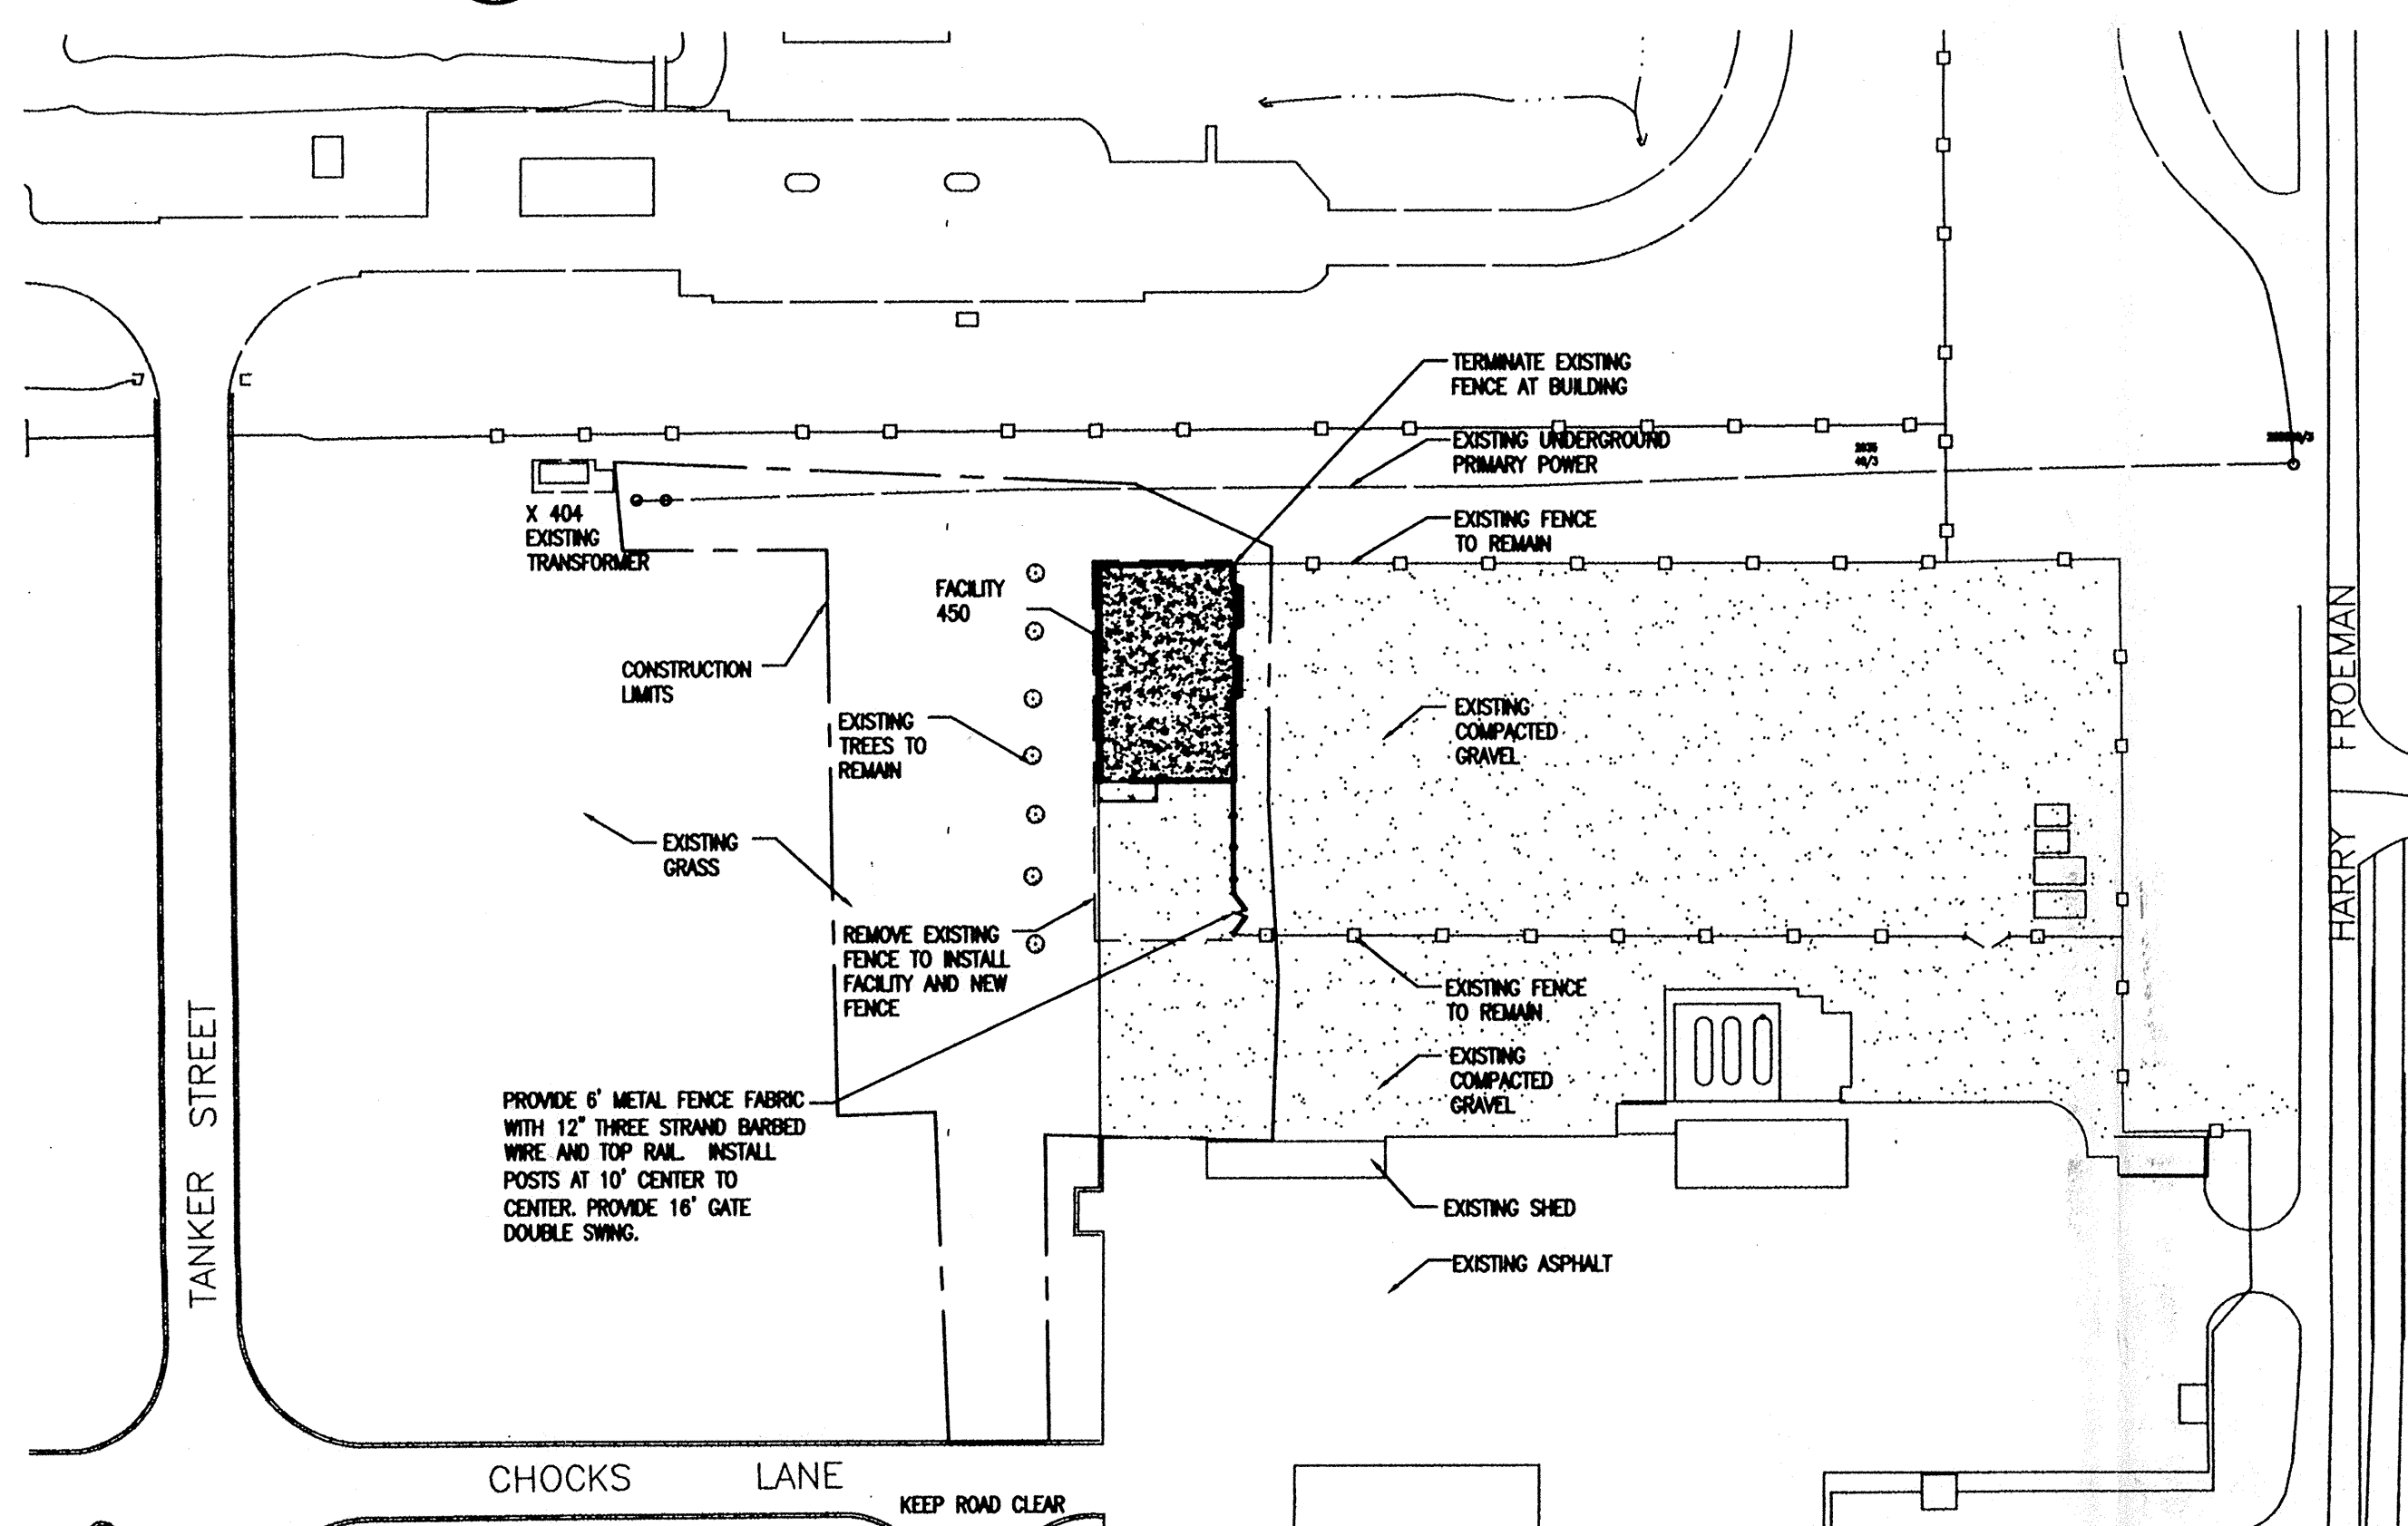

3
G001 SITE PLAN

CONTENTS

G101	TITLE SHEET AND SITE PLAN
A101	PLANS AND ELEVATIONS
E101	ELECTRICAL

Project Coordination

W. C. [Signature]	Date	Ch. [Signature]	Date	Utility Agency	Date
B. A. [Signature]	Date	Wing Phase	Date	Airfield Management	Date
RPM manager	Date	NR/ARO	Date	Construction (CEDD)	Date
J. [Signature]	Date	Environmental (SDP)	Date	Engineering (CE)	Date
Comptroller (AC)	Date	Gen. Dist. (GP)	Date	Legal (LA)	Date

Approved: [Signature] Date: 02/29/2017
Base Civil Engineer

Approved: [Signature] Date: 03/16/2017
Commander

RECEIVED
-3 MAR 2010 10 36
NORTH CONTRACTING OFFICE
CRISMON AND INDIANA

AS-BUILT
28 Jan 2010

34TH CONTRACTING OFFICE
GRISWOLD ARB INDIANA
16 MAR 2010 13 33
RECEIVED

28 JAN 2013