



National Park Service

**Replace Wastewater Plant South Rim Village
GRCA-257282**

**100% Complete Construction Documents
Addendum 4**

September 8, 2026

Prepared by:

Jacobs Government Services Company

Greenwood Village, CO

Contract No. 140P2023D0006

Task Order No. 140P2023F0235



Jacobs

1. Addendum Contents

This addendum addresses questions from bidders on the 100% Final Construction Documents for the Replace Wastewater Plant South Rim Village project, dated June 2025, that were received by Jacobs on August 27, 2026. The questions and responses are attached. The questions resulted in minor updates to drawings. Revisions are captured in markup format showing additions in red, deletions in green and notes in blue. Revised documents are listed below and attached. Revised documents will ultimately be incorporated into conformed contract documents after project award.

1.1 Revisions to Drawings

New or Updated	Sheet No.	DWG No.	Sheet Name	Description
Updated	391	87S1030	Compost Facility Structural Foundation Plan and Detail	Added Detail 2 for drilled pier reinforcement
Updated	361	80D3002	Digester Facility Mechanical Sections	Revised detail number and valve size





1.2 Revisions to Standard Details

New of Updated	Standard Detail No.	Name	Description
		None	

1.3 Revisions to Specifications

New of Updated	Specification No.	Name	Description
		None	

PLOT DATE: 16-JUN-2025 PLOT TIME: 14:34 SS6/V8i D3167666 - South Rim/4 Delivery/43 CAD Design/GRCA257282/Microstation V8i Drawings/STRUCT/87S1030_D3167666.dgn

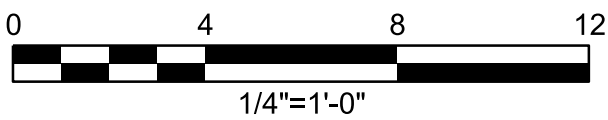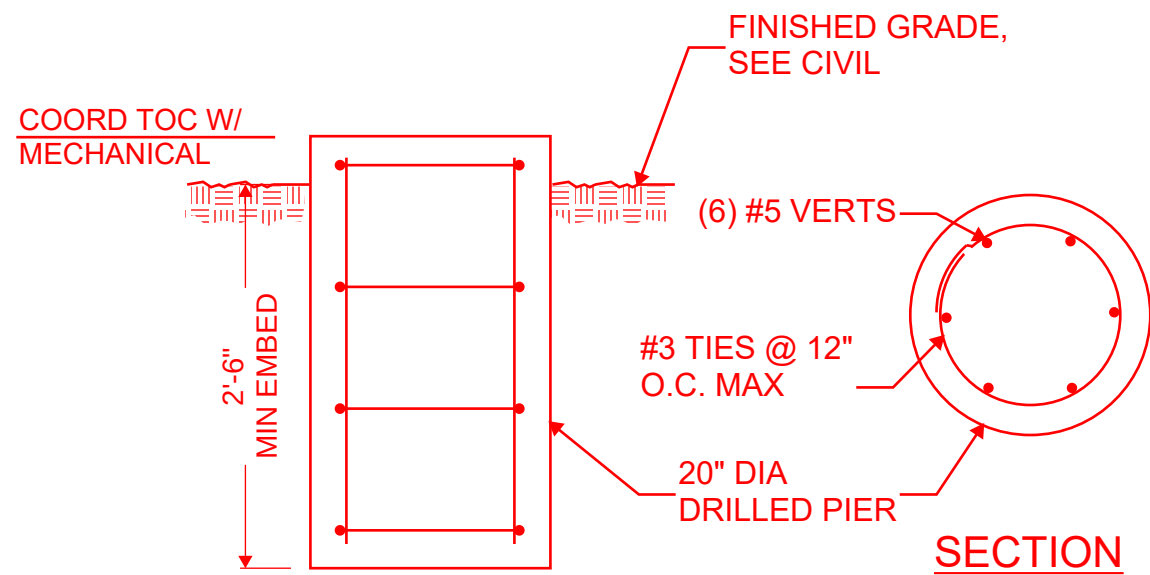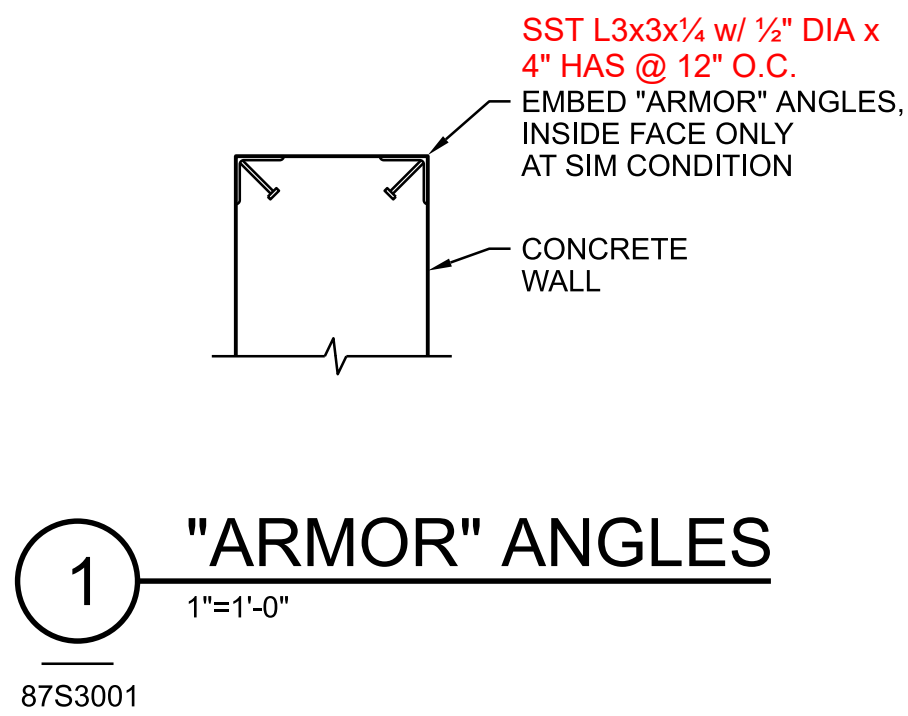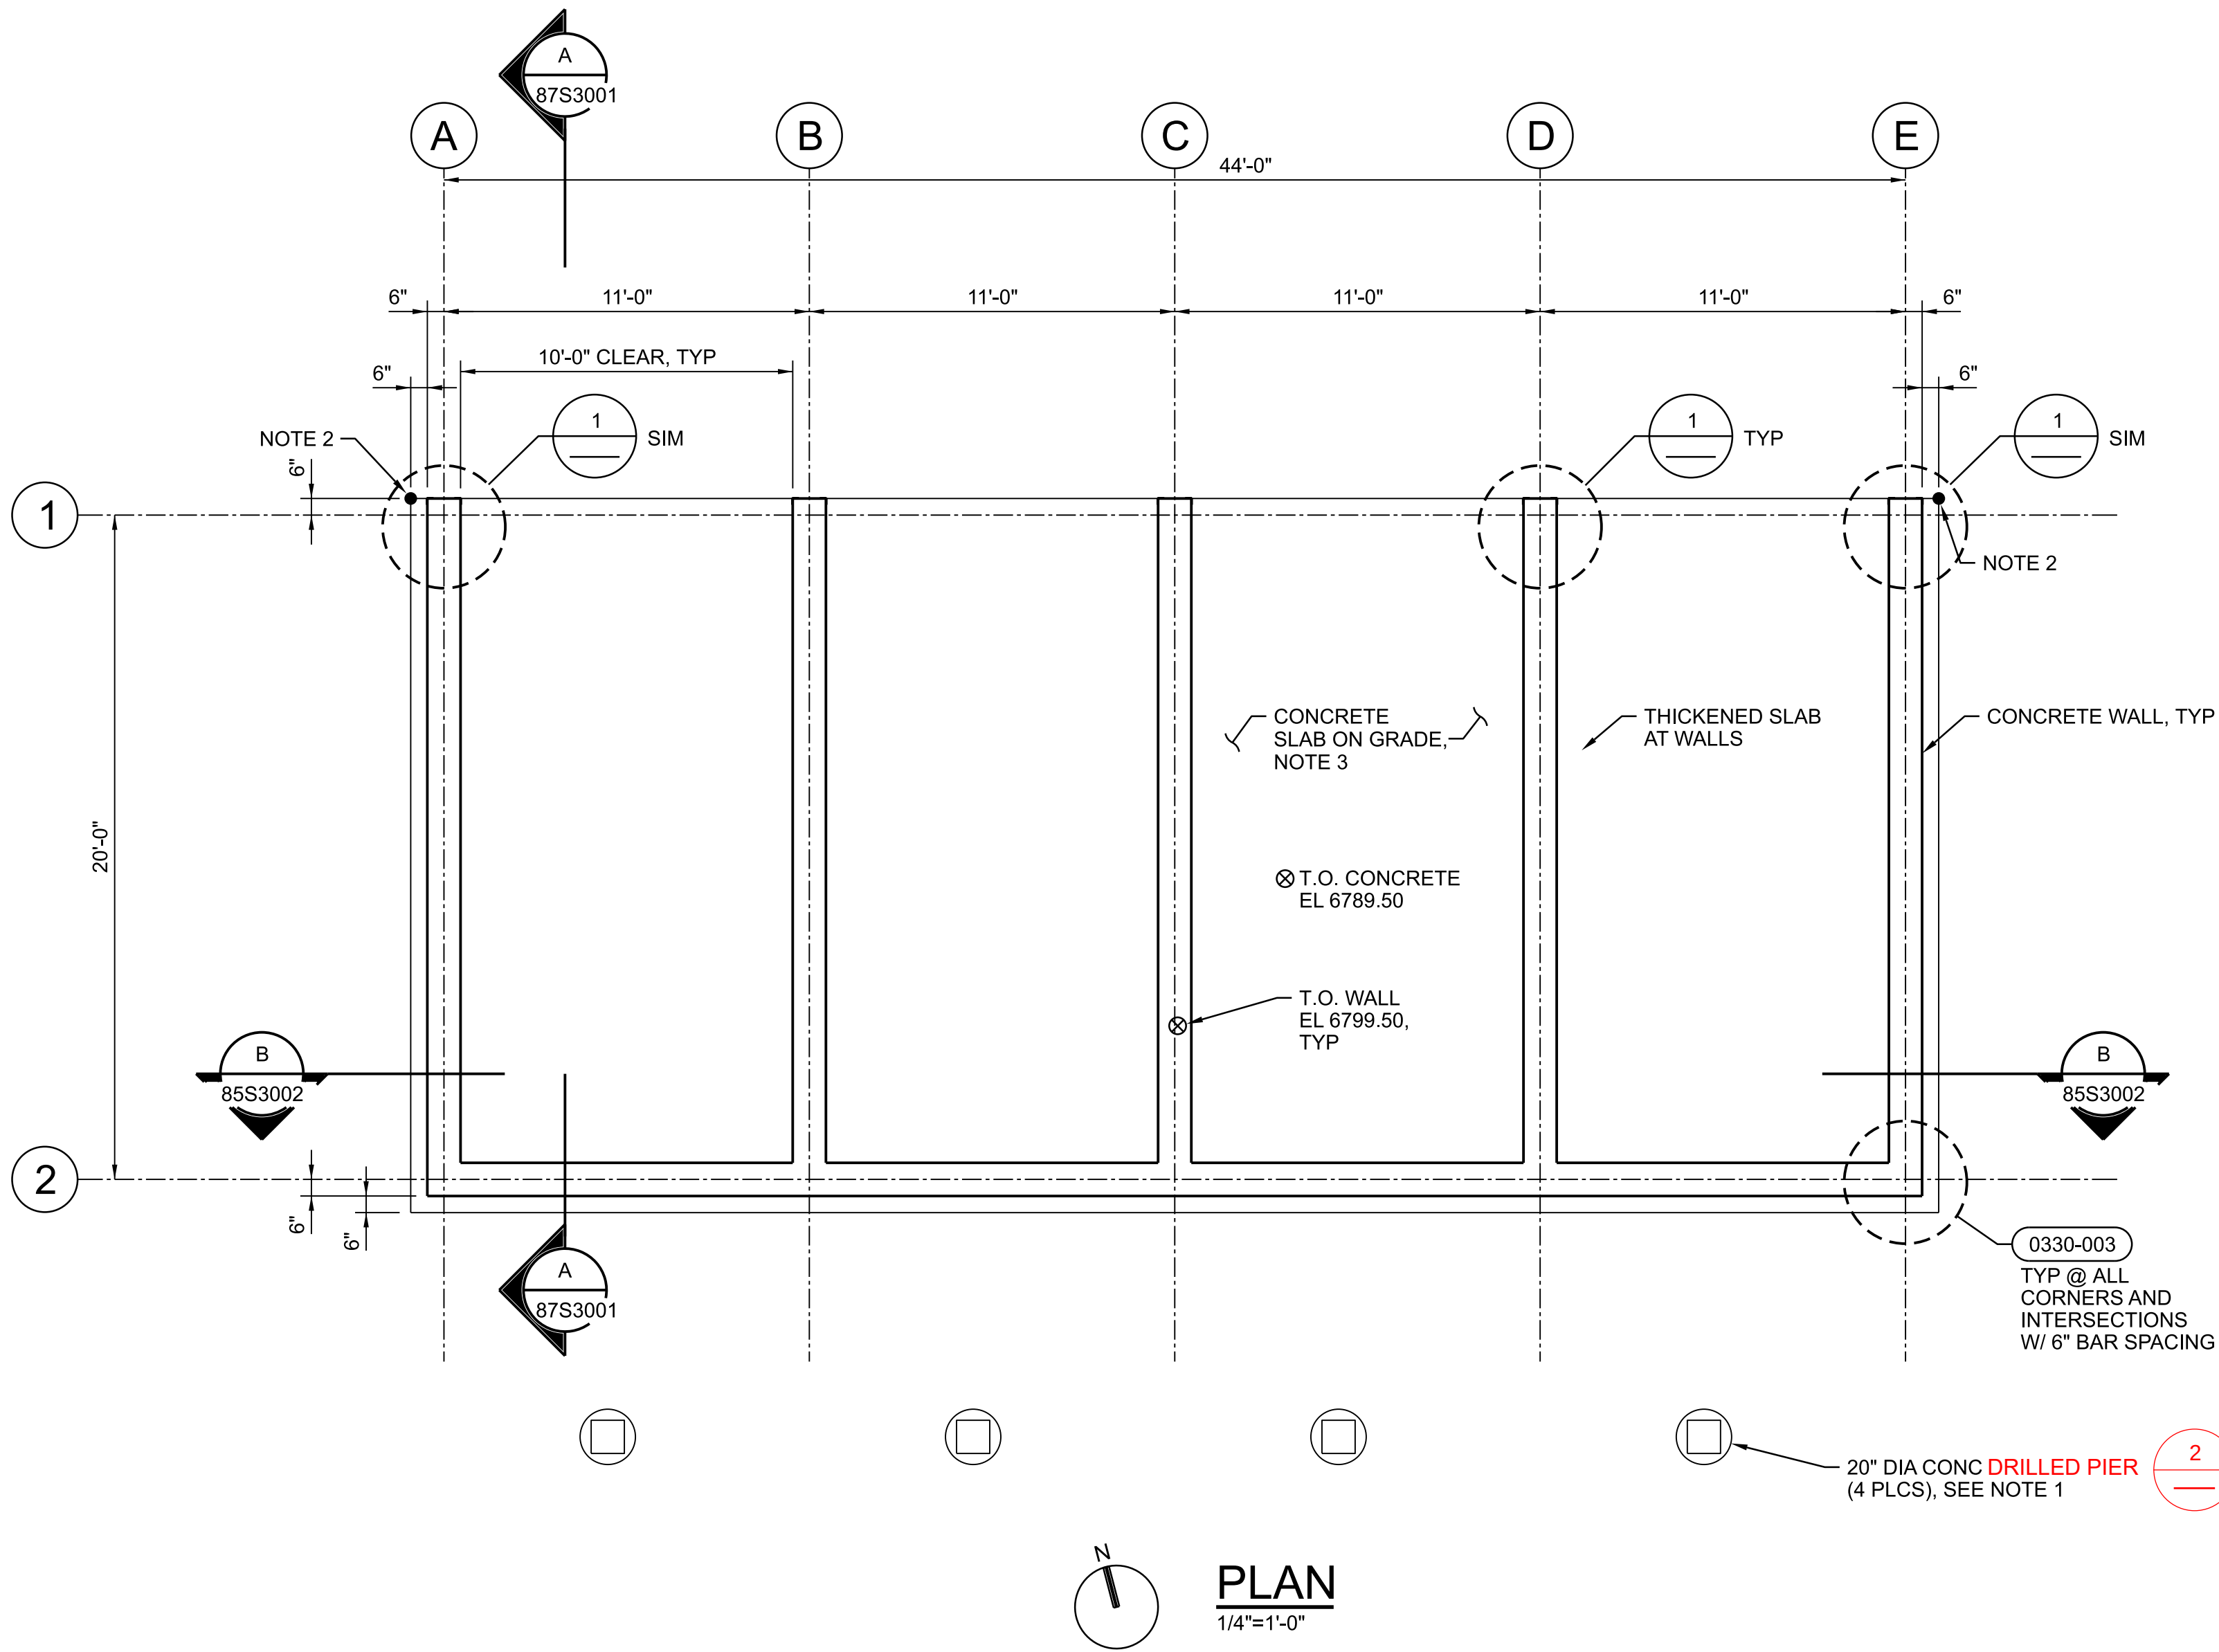

GENERAL SHEET NOTES

A. FOR GENERAL STRUCTURAL NOTES SEE DRAWINGS 01S0001 AND 01S0002.

SHEET NOTES


- COORDINATE LOCATION WITH MECHANICAL.
- FACILITY LOCATION CONTROL POINT. SEE CIVIL DRAWING 06C2001.
- REINFORCE SLAB-ON-GRADE WITH #5@12" EW, T&B.

PLAN
1/4"=1'-0"


FULL SIZE DRAWINGS = 22"x34"
BAR MEASURES 1" LONG




A/E FIRM JACOBS GOVERNMENT SERVICES COMPANY GREENWOOD VILLAGE, CO	DESIGNED: W KOHLER	SUB SHEET NO. 87S1030	TITLE OF SHEET COMPOST FACILITY STRUCTURAL FOUNDATION PLAN AND DETAIL GRAND CANYON, SOUTH RIM	DRAWING NO. 113
	CADD: B CLEGG			PMIS/PKG NO. 257282
	TECH. REVIEW: A FIRTH			SHEET
	DATE: 06/2025			391 OF 401

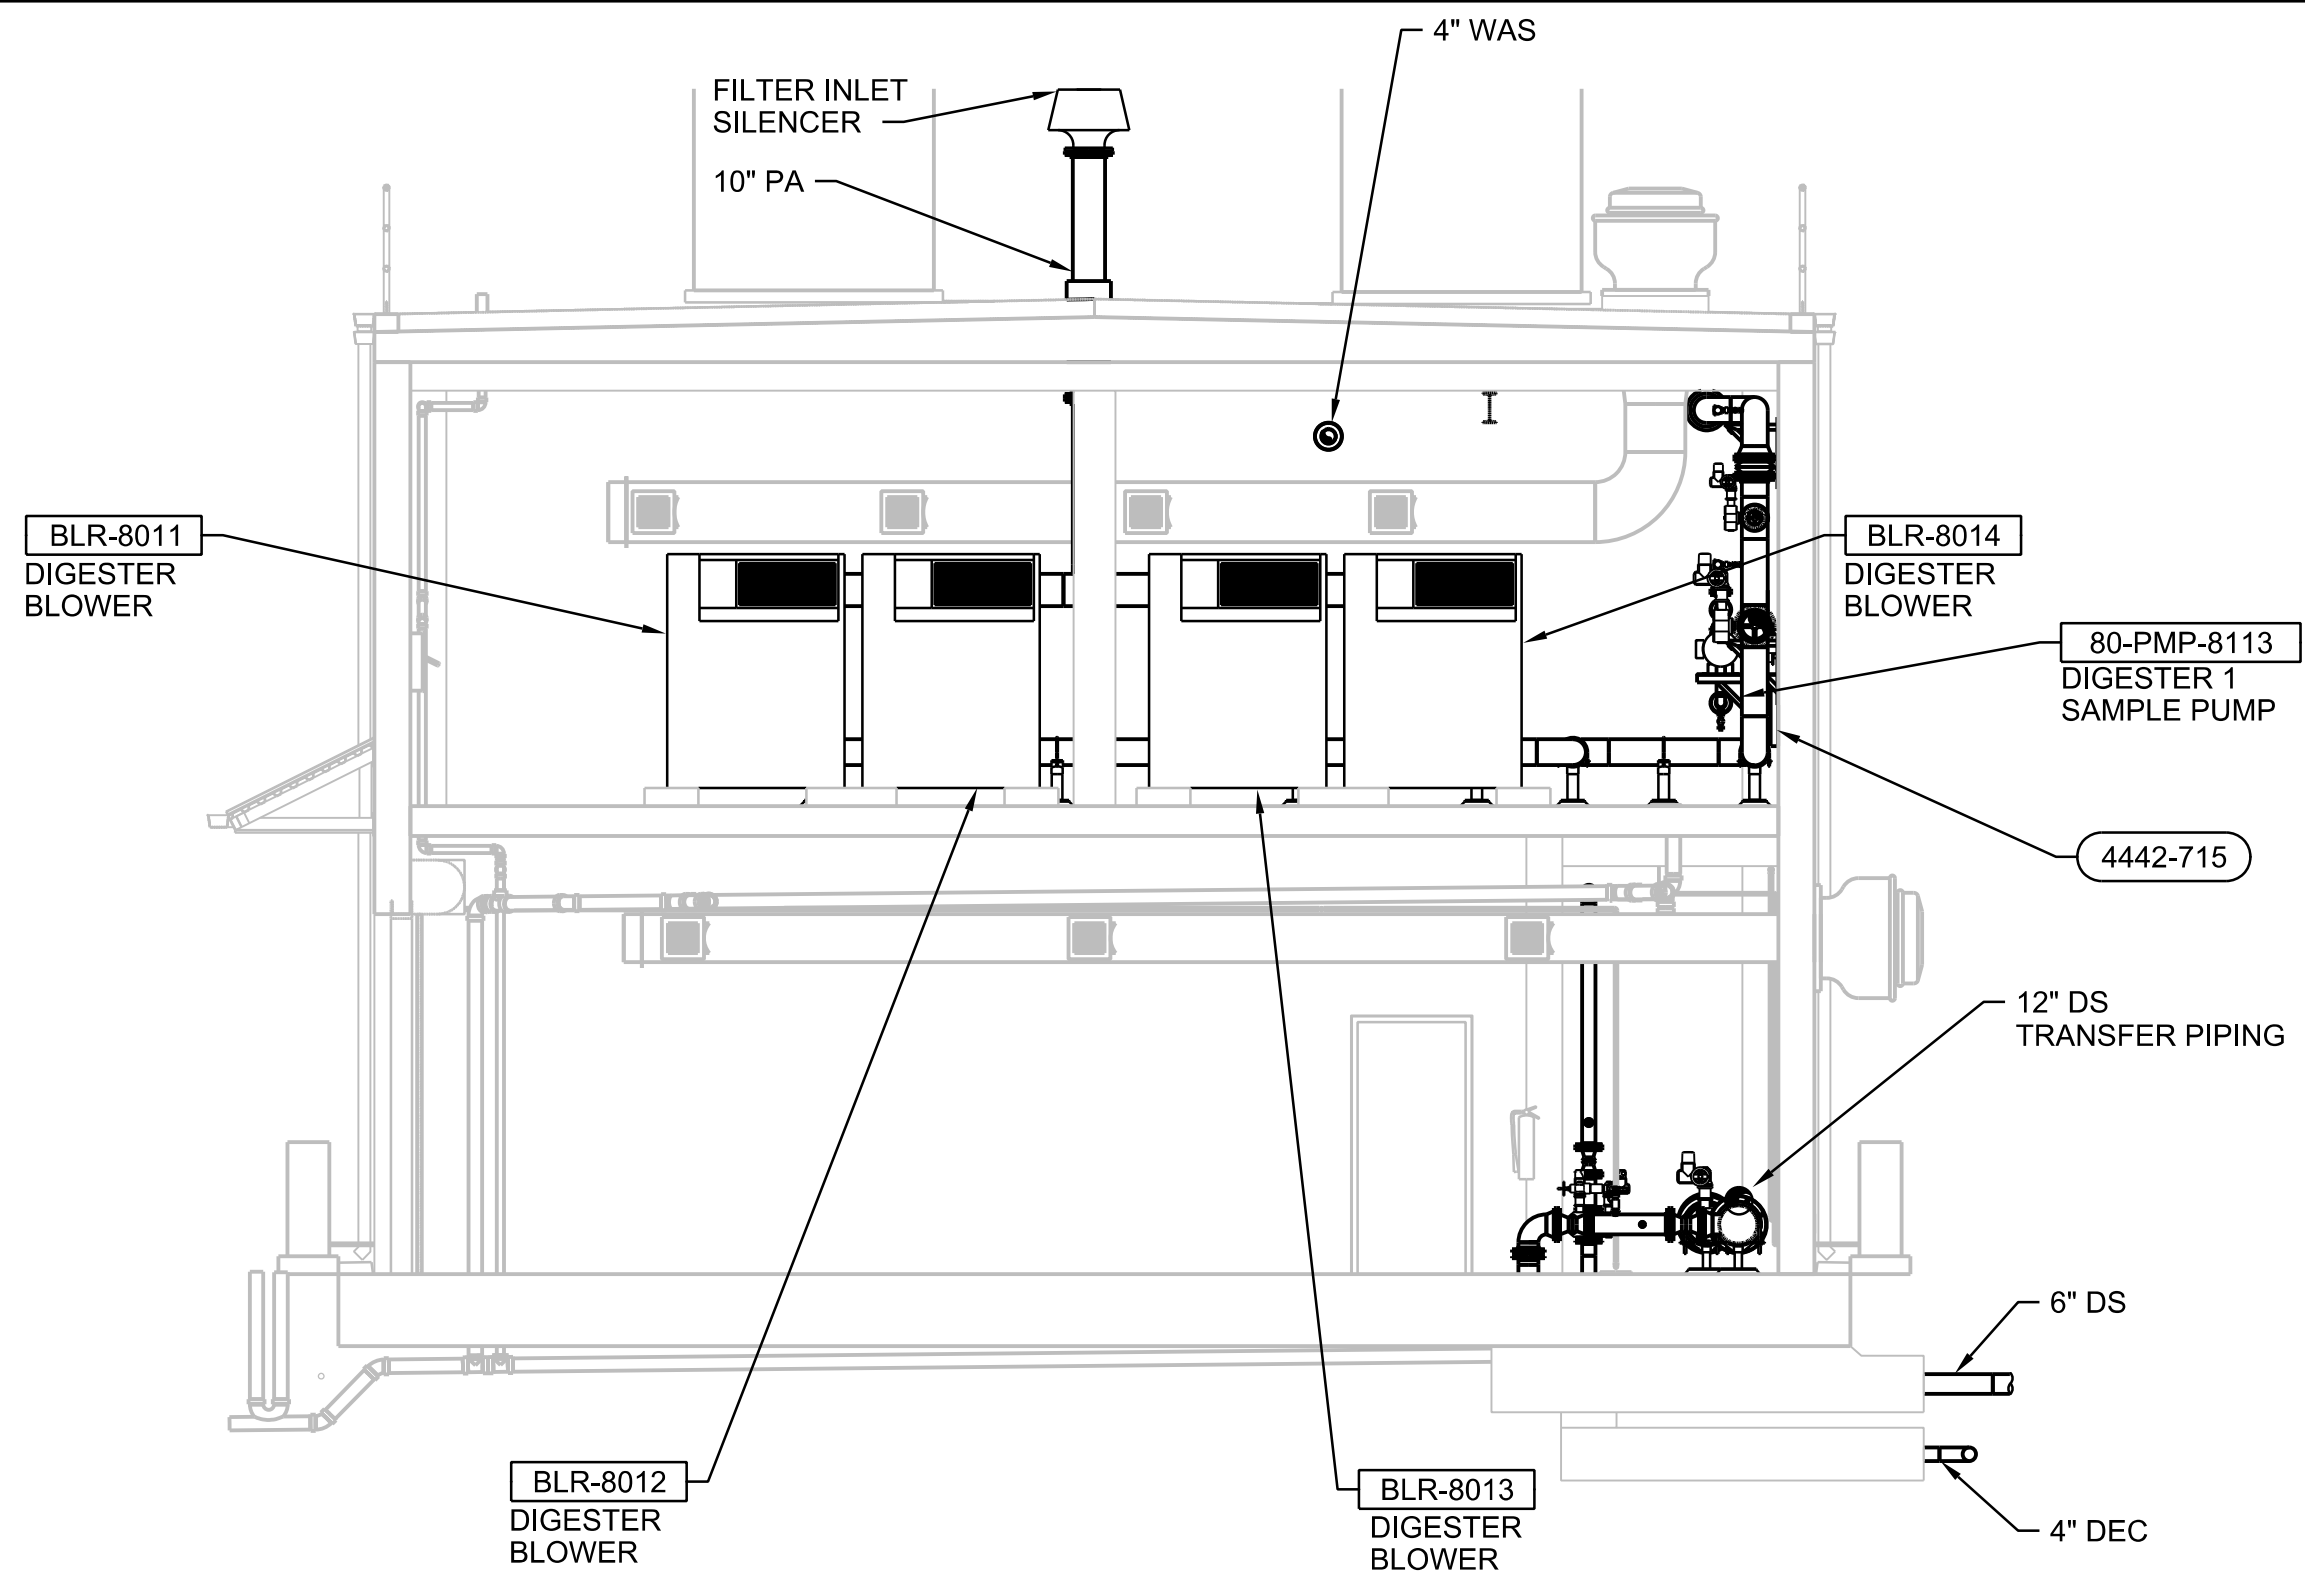


C SECTION
3/16"=1'-0"
80D1030 0 4 8 16
80D1040 3/16"=1'-0"

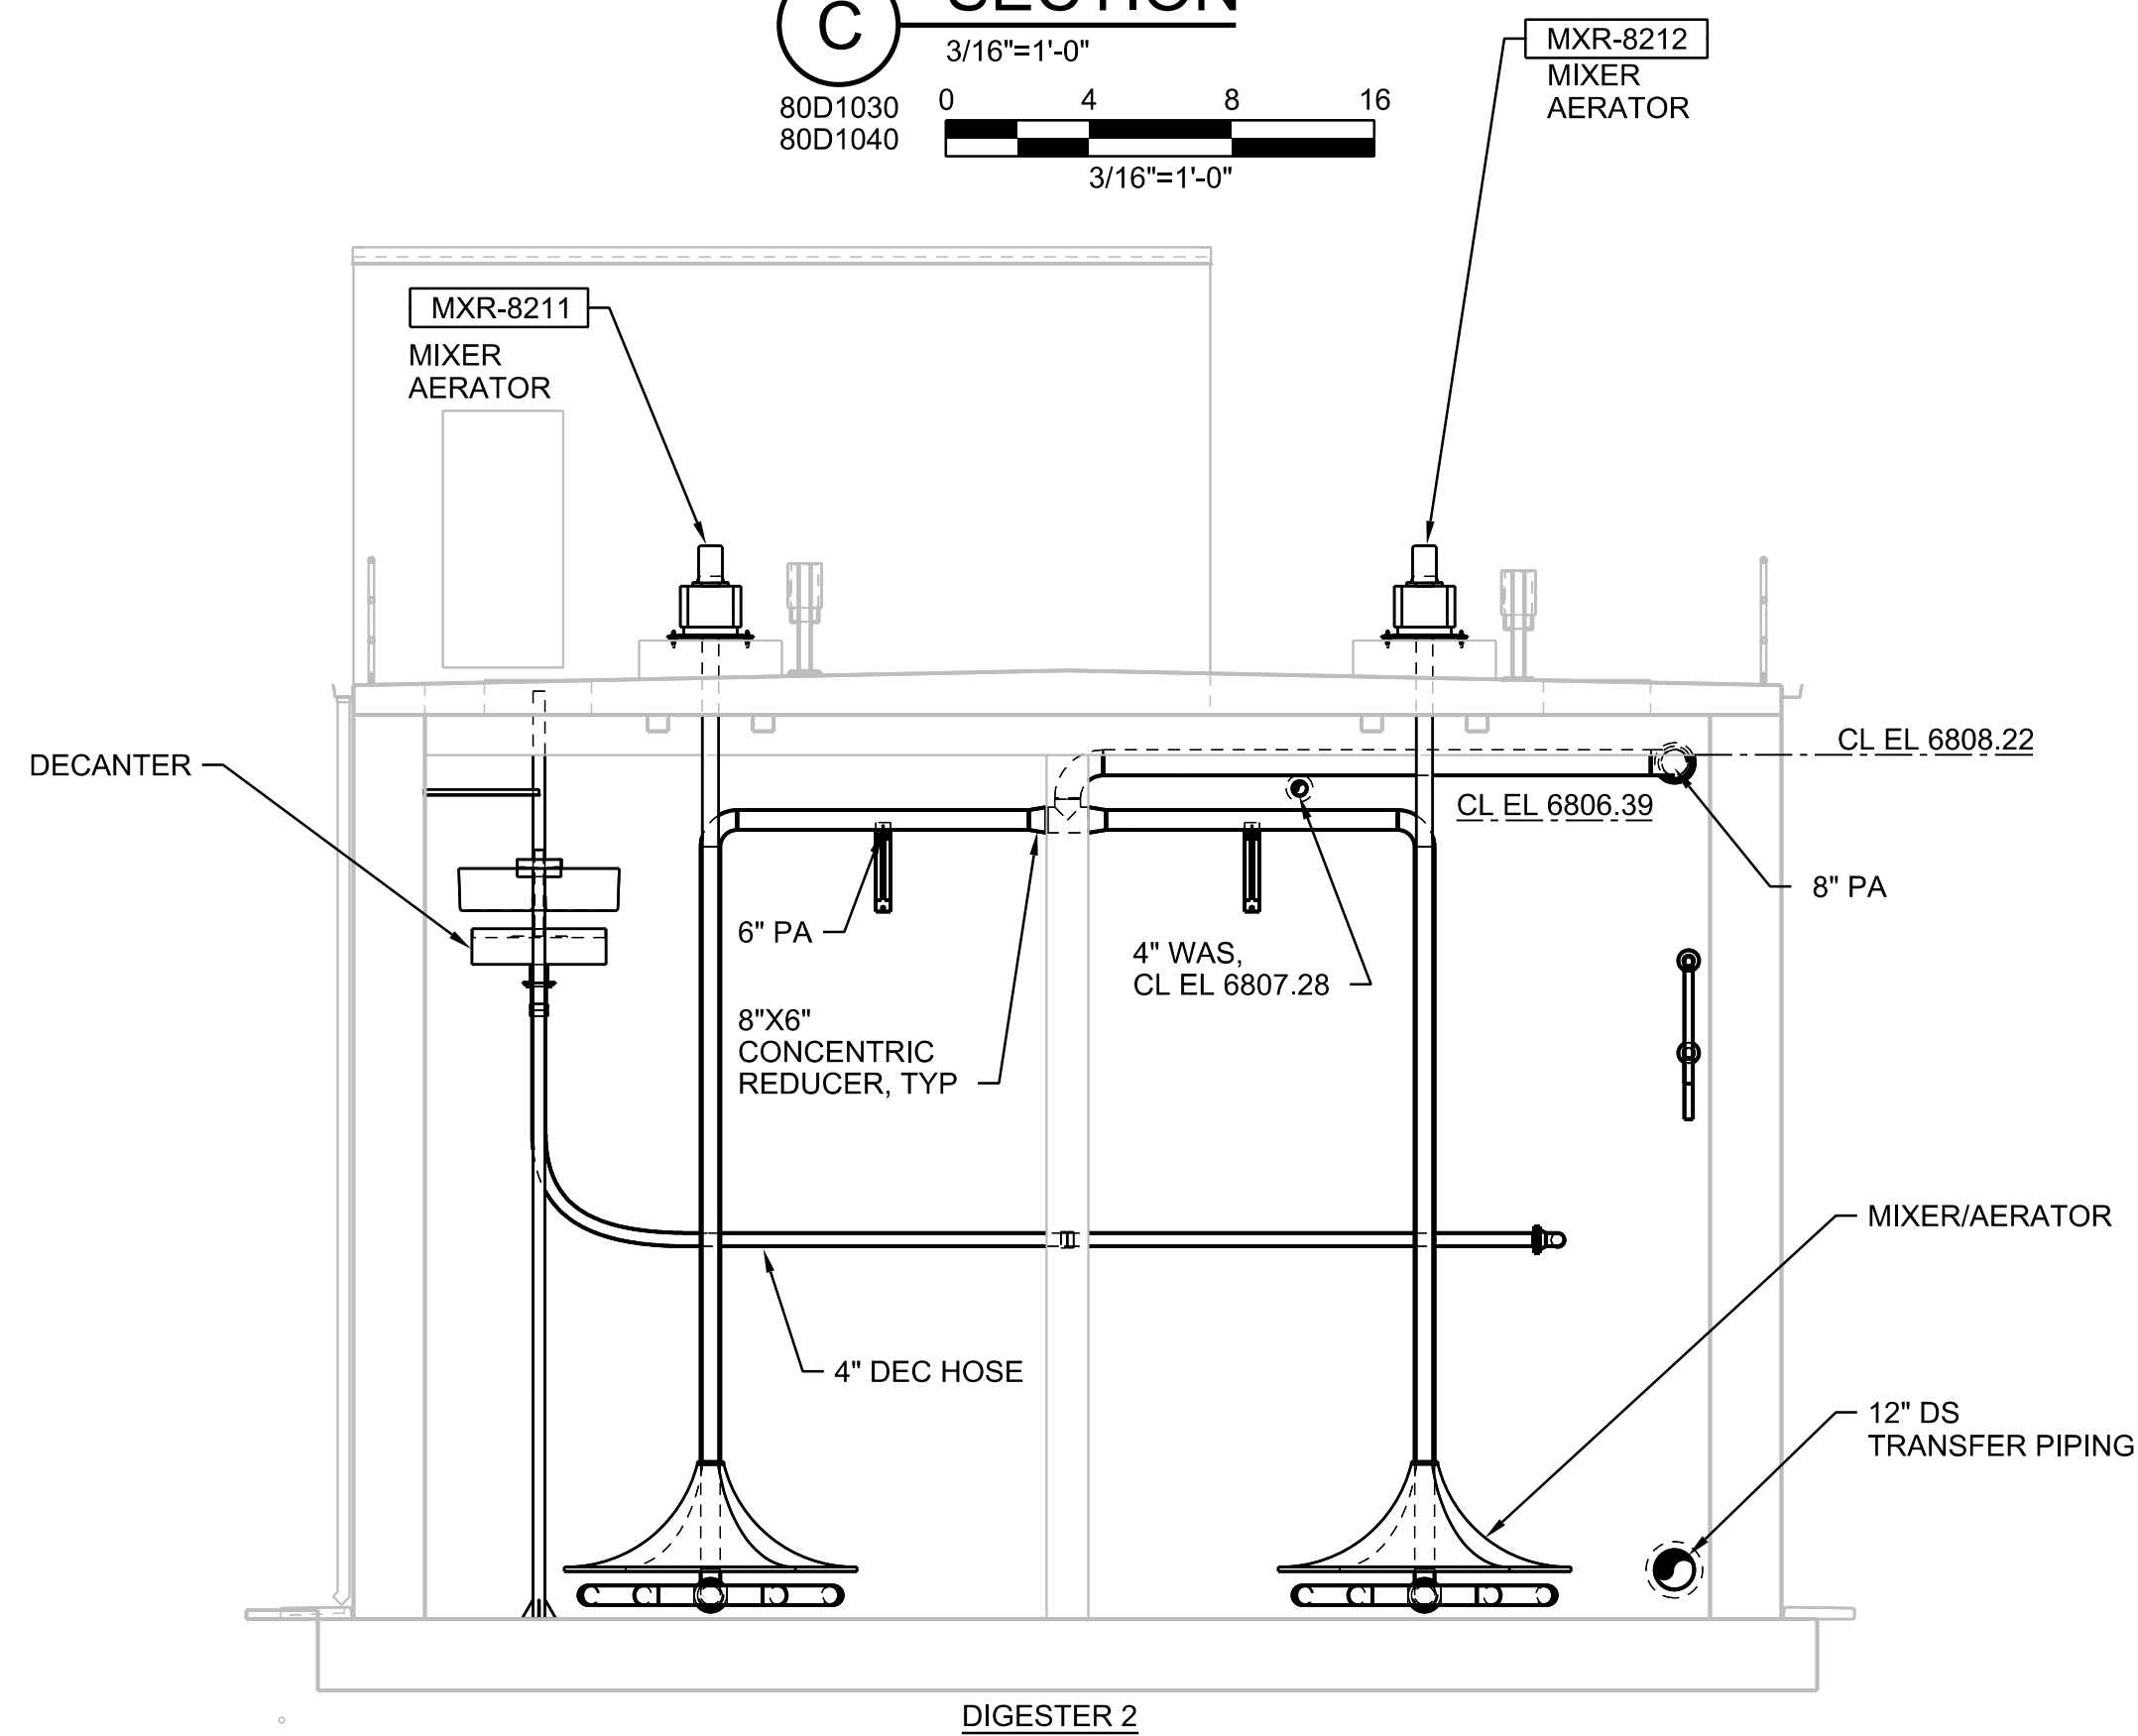


D SECTION
3/16"=1'-0"
80D1030 0 4 8 16
80D1040 3/16"=1'-0"

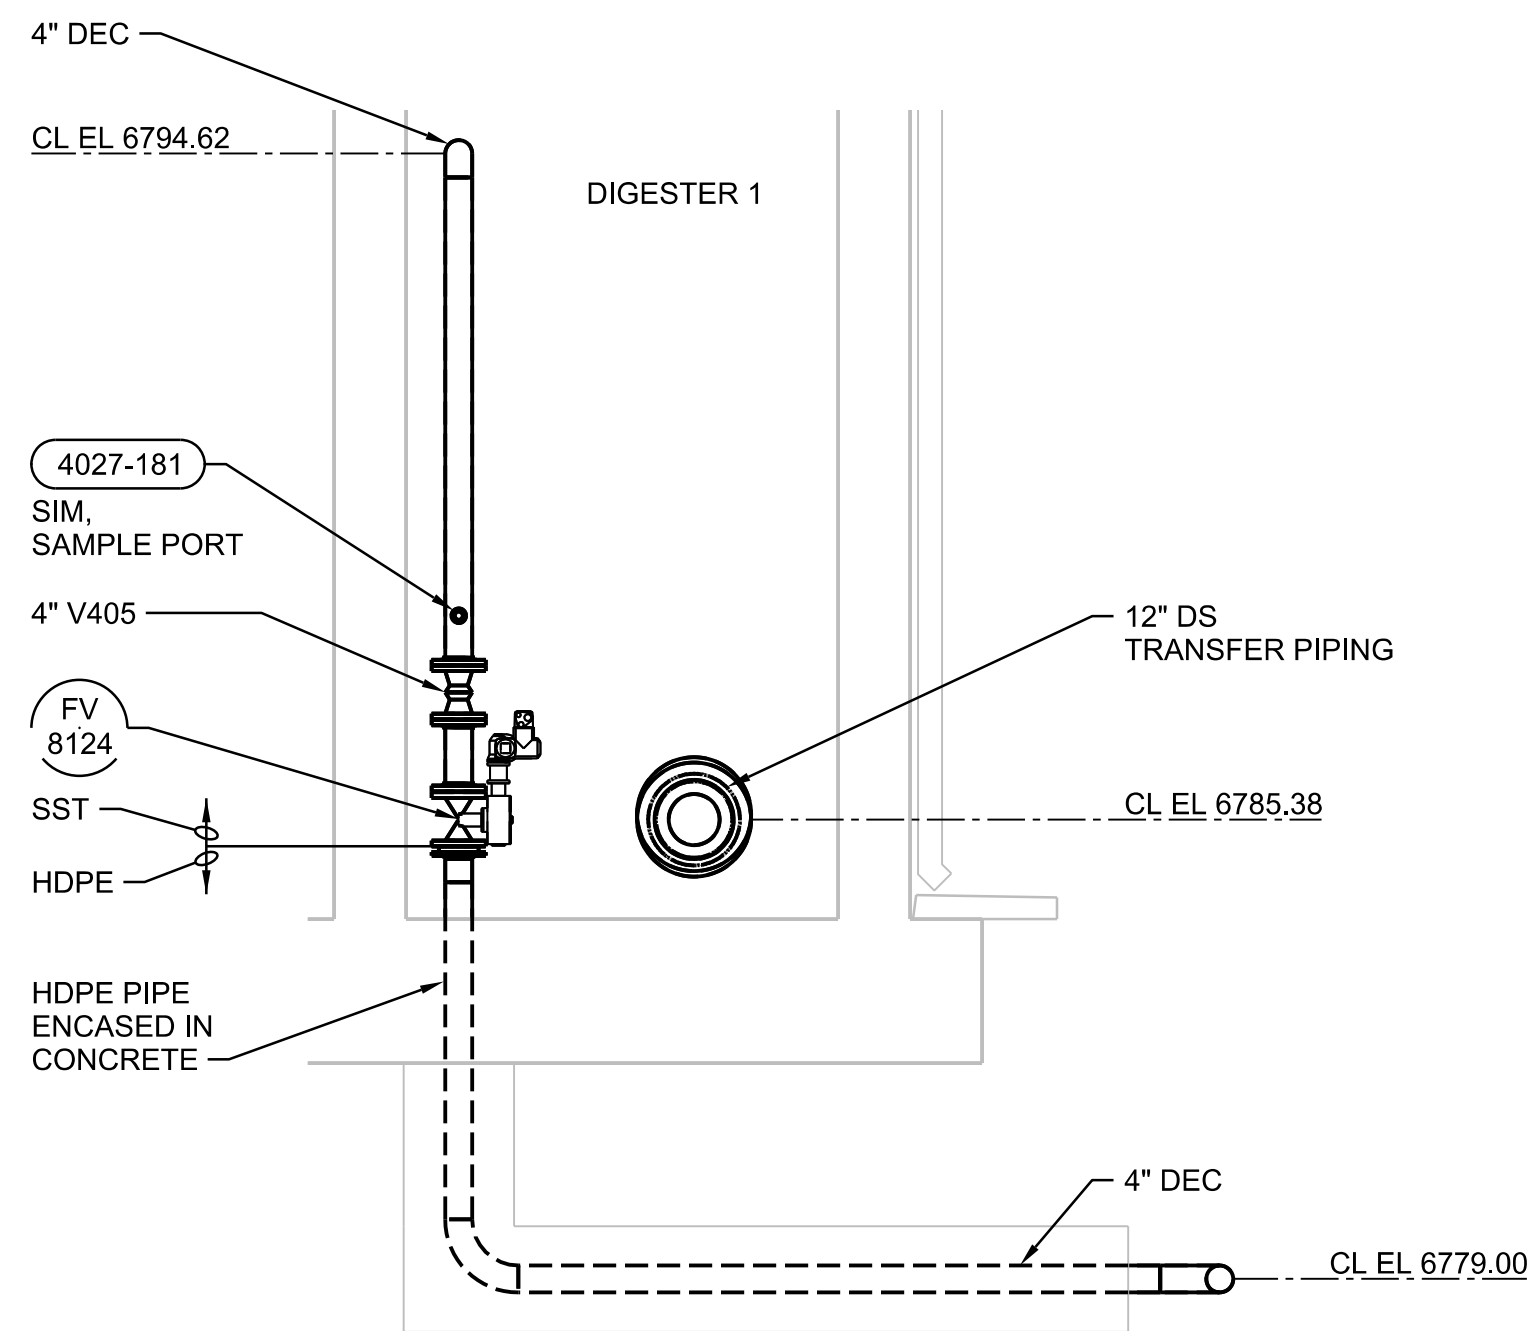


E SECTION
3/8"=1'-0"
80D1030 0 2 4 6
3/8"=1'-0"

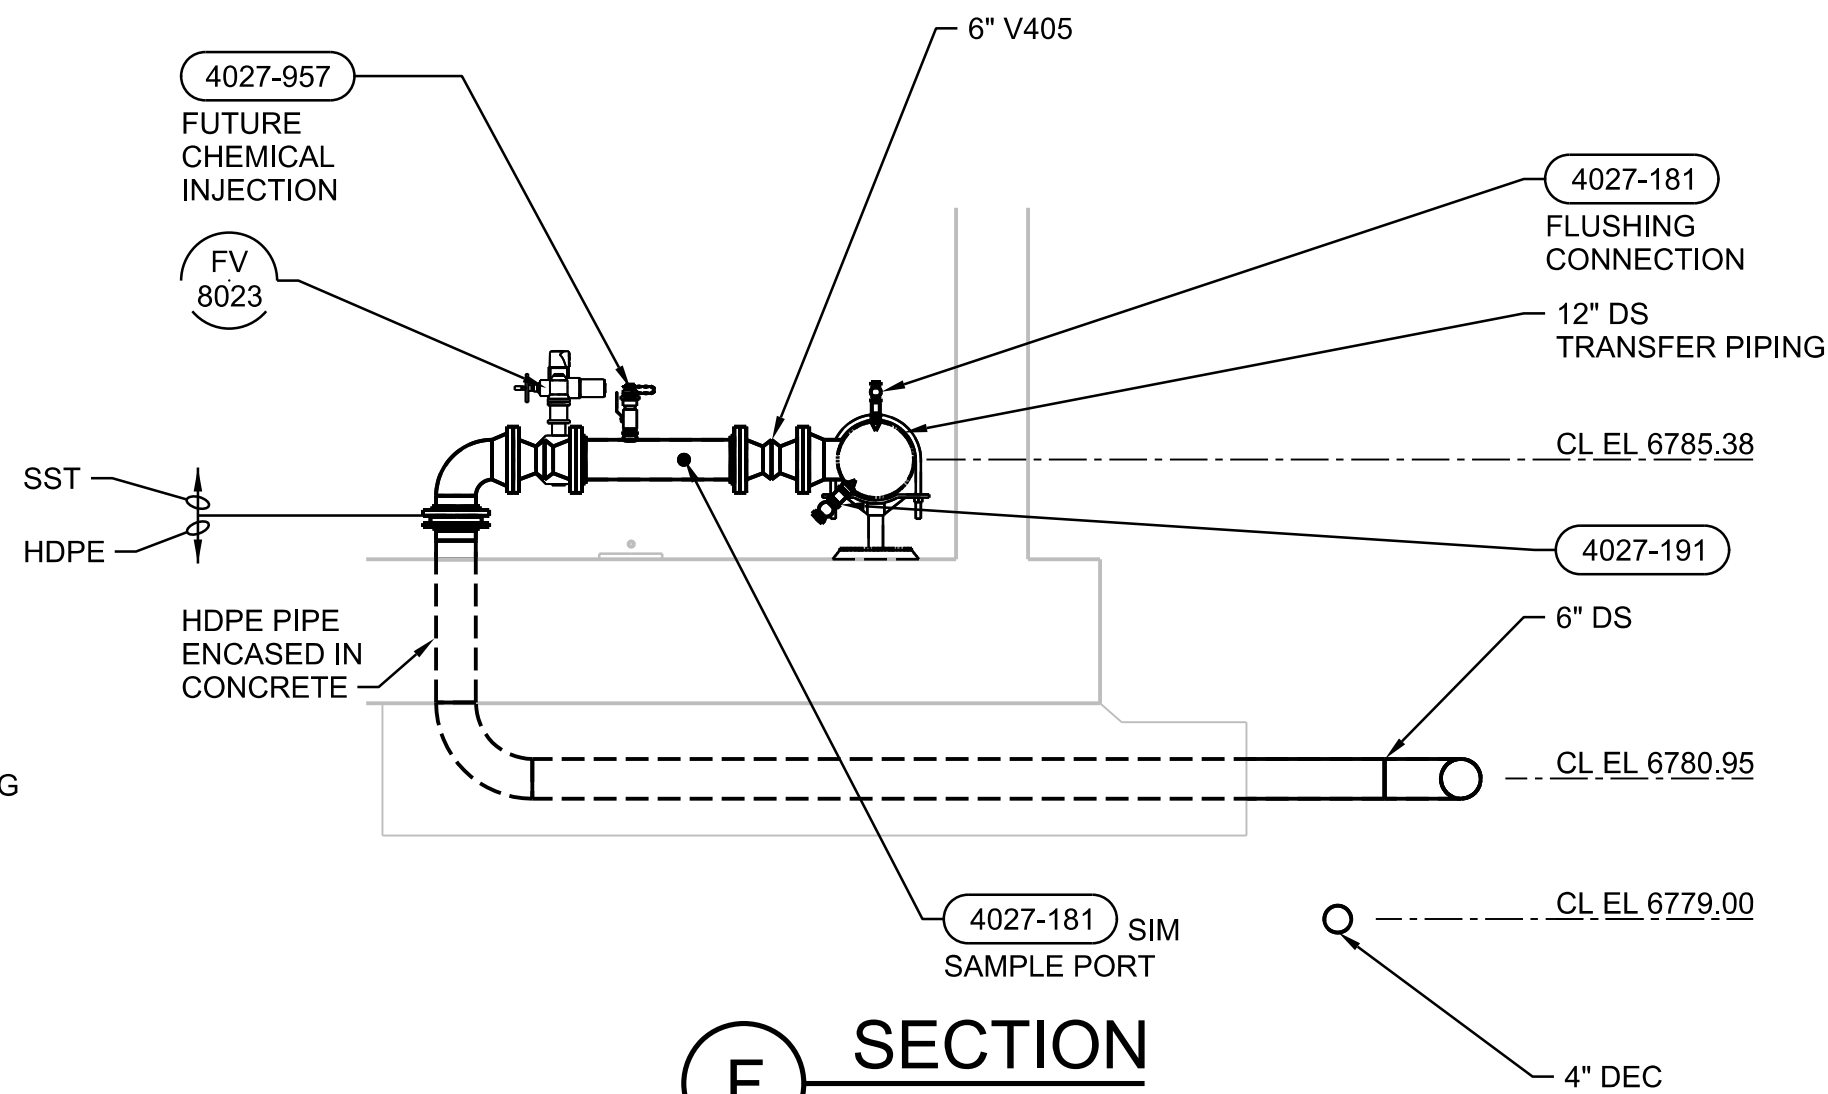

F SECTION
3/8"=1'-0"
80D1030 0 2 4 6
3/8"=1'-0"

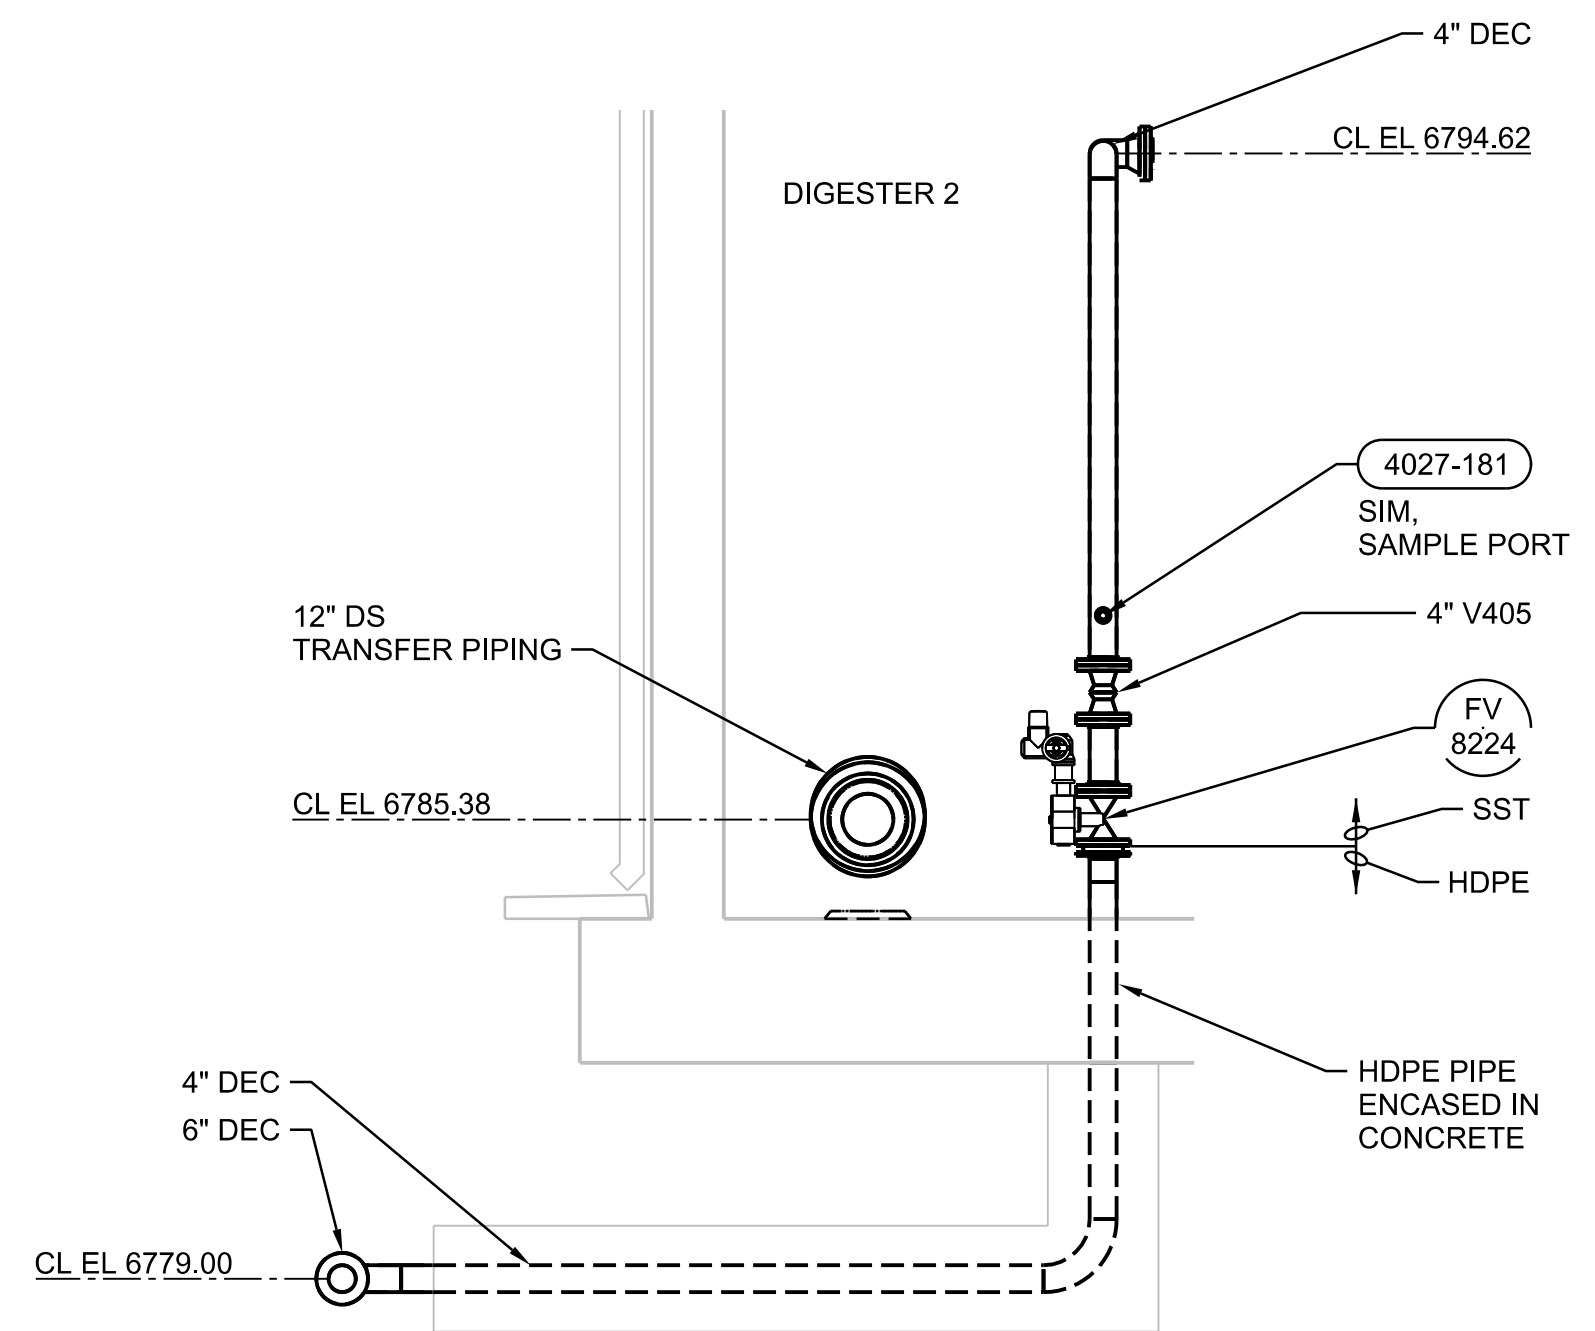

H SECTION
3/8"=1'-0"
80D1030 0 2 4 6
3/8"=1'-0"

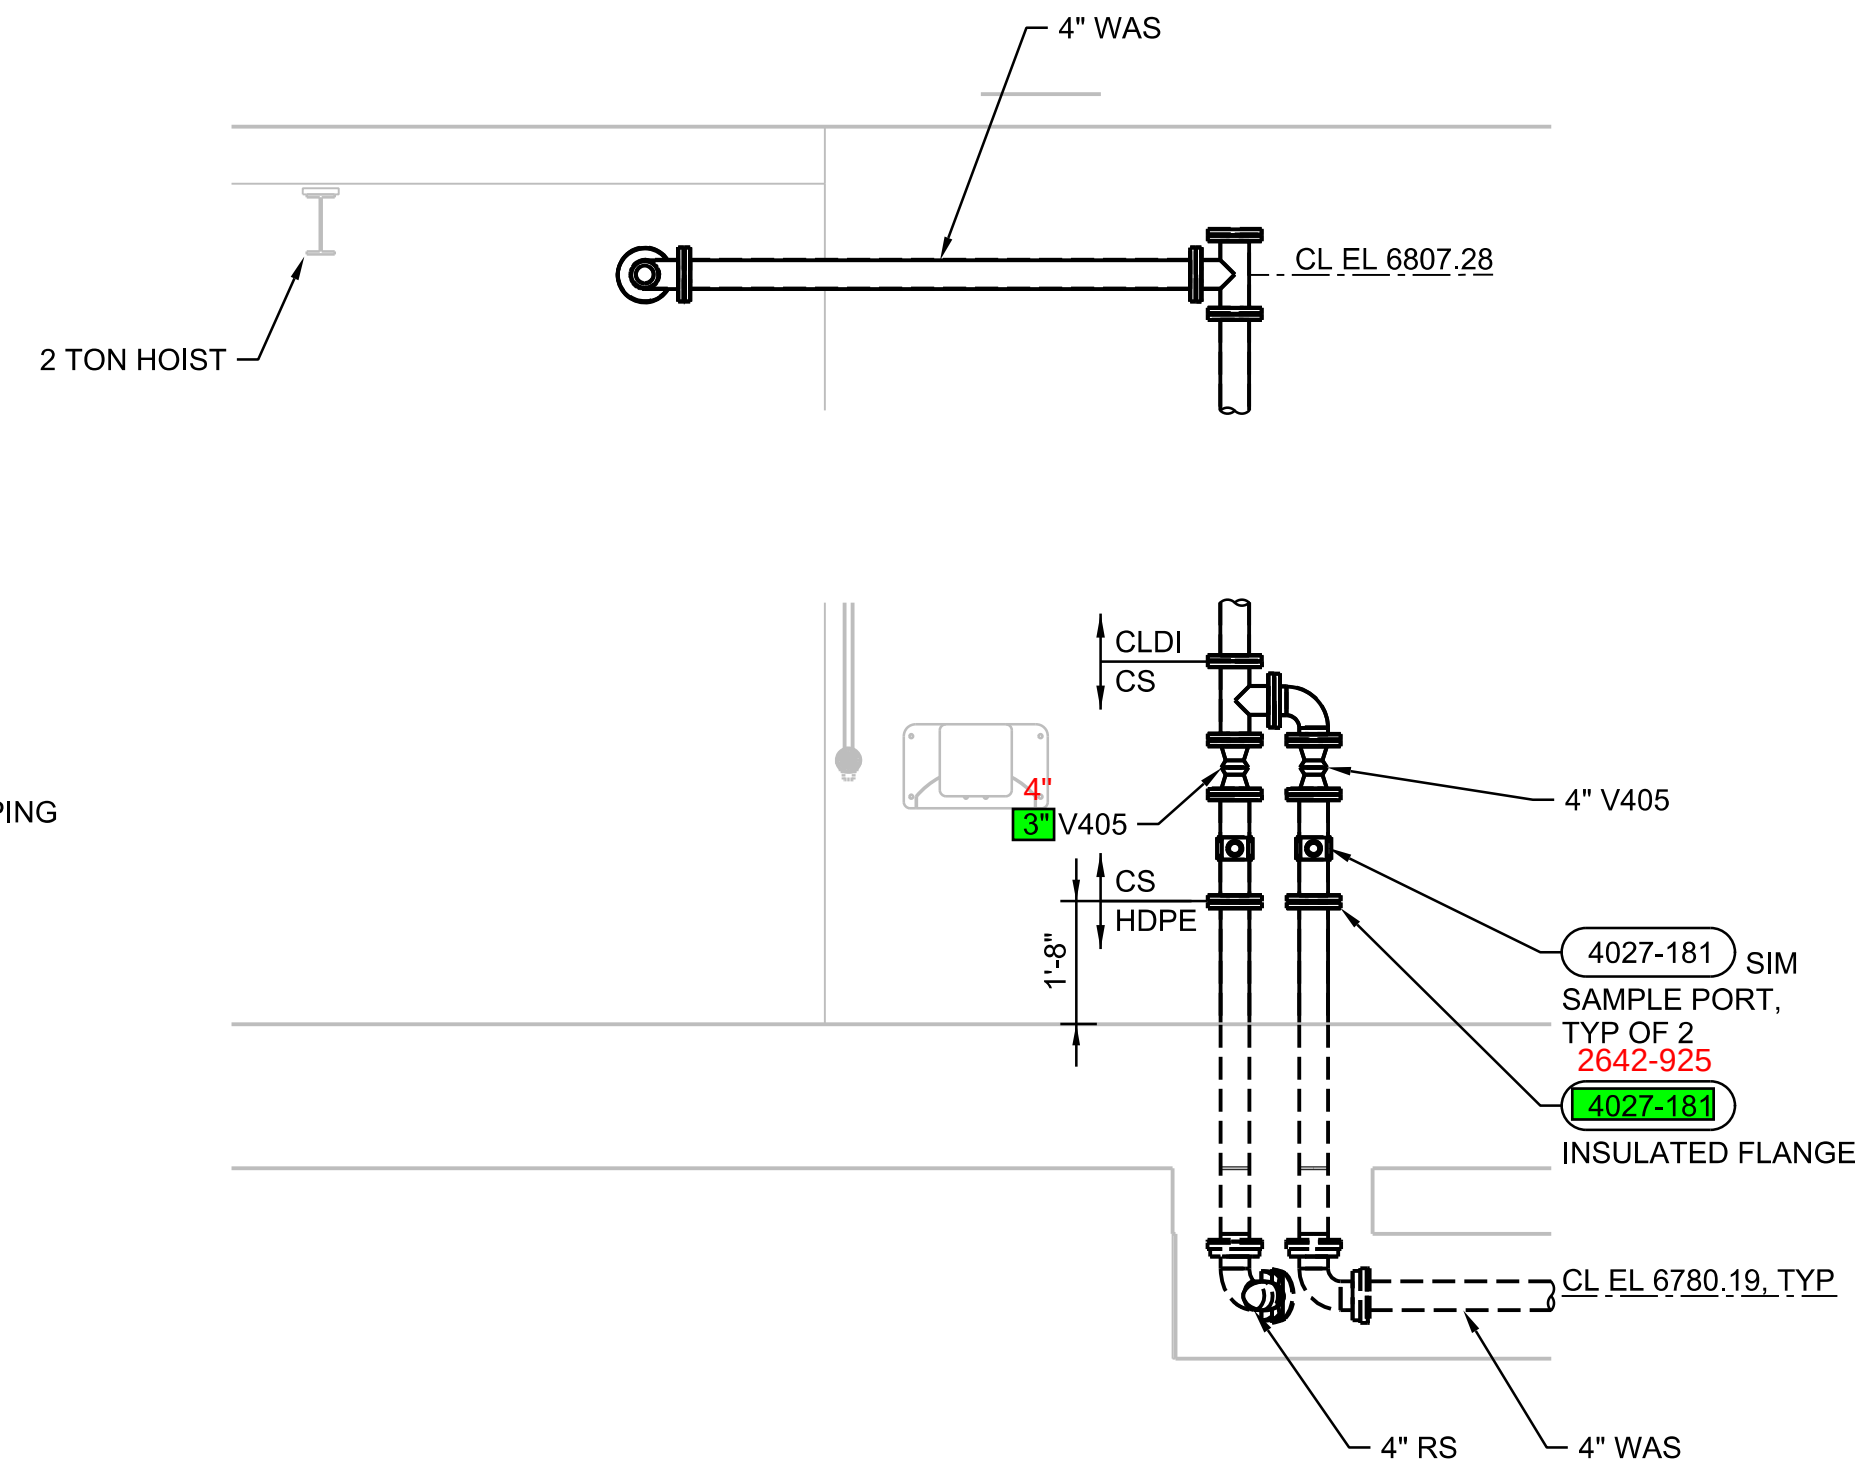

G SECTION
3/8"=1'-0"
80D1030 0 2 4 6
3/8"=1'-0"

FULL SIZE DRAWINGS = 22"x34"
BAR MEASURES 1" LONG

0" 1"

	A/E FIRM	DESIGNED:	SUB SHEET NO.	TITLE OF SHEET DIGESTER FACILITY MECHANICAL SECTIONS		DRAWING NO. 113 175376	
	JACOBS GOVERNMENT SERVICES COMPANY	CADD:					
	GREENWOOD VILLAGE, CO	TECH. REVIEW:					
		DATE:					
		C LANCASTER	80D3002	GRAND CANYON, SOUTH RIM		PMIS/PKG NO. 257282	
		N HUBER				SHEET	
		D BRUNKOW				361 OF 401	